


# WATER WELL DRILLERS LOG

LEE  
 E 30 15-26-61, Driller: Erving C. Lee County Lee  
 Date: 5-26-61 (Name)  
 5-26-61

	Description & Color of Materials Sand, Clay, Red Clay, Shell, etc.	Thick- ness Feet	Depth Feet
(1) Owner of Land: <u>Billy Young</u> (Name) <u>Arthur Young</u> (Address)			
(2) Location: <u>SW 1/4, SE 1/4, Sec. 27-T 8 S R 6 E</u> _____ miles _____ of _____ (distance) (direction) (Nearest Town)	↑ N		
(3) Topography: _____ (Hilly) (Flat) (Level)			
(4) Purpose of Well: <u>Household</u> (Domestic Irrigation, Municipal, Industrial, Other)			

**Information upon completion of well:**

(1) Diameter 4 inches.  
 (2) Total Depth 432 feet.  
 (3) Water Level 115 feet below top of ground.  
 (4) Cased to 69 ft Size 4"  
 (5) Screen: Size \_\_\_\_\_, Length \_\_\_\_\_  
 (6) Were any formations sealed against pollution?  
 yes,  no.  
 If YES depth of formation 69 ft  
 Why \_\_\_\_\_  
 Drillers Remarks: \_\_\_\_\_  
 \_\_\_\_\_  
78 ELEV 400

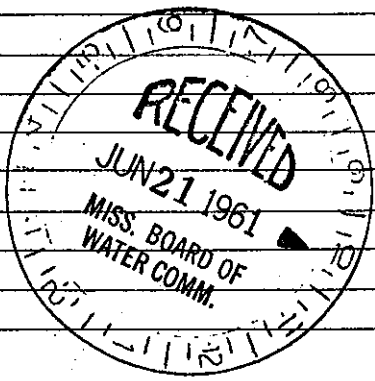

Well No.

(Use Back Side)