

LEE  
E 31  
6-18-62


MISSISSIPPI BOARD OF WATER COMMISSIONERS

WATER WELL DRILLERS LOG

Date: 6-18, 1962, Driller: O.C. Webb Jr., County Lee

(Name)


	Description & Color of Materials Sand, Clay, Red Clay, Shell, etc.	Thick- ness Feet	Depth Feet
(1) Owner of Land: <u>J. W. Spicer</u> (Name) <u>Supelo miss</u> (Address)	<u>Soil to 17ft sand</u> <u>to 115ft 6" Rock</u> <u>Sand course to</u> <u>190ft Blue marl</u> <u>to 300ft water</u> <u>Rock 3 1/2 in water</u> <u>sand to 500ft</u> <u>Utaw sand</u>		
(2) Location: <u>SW 1/4, NW 1/4, Sec. 9 T8R6E</u> <u>2 1/2 miles north</u> of <u>Saltville</u> (distance) (direction) (Nearest Town)			
(3) Topography: <u>Level</u> (Hilly) (Flat) (Level)			
(4) Purpose of Well: <u>Other</u> (Domestic Irrigation, Municipal, Industrial, Other)			

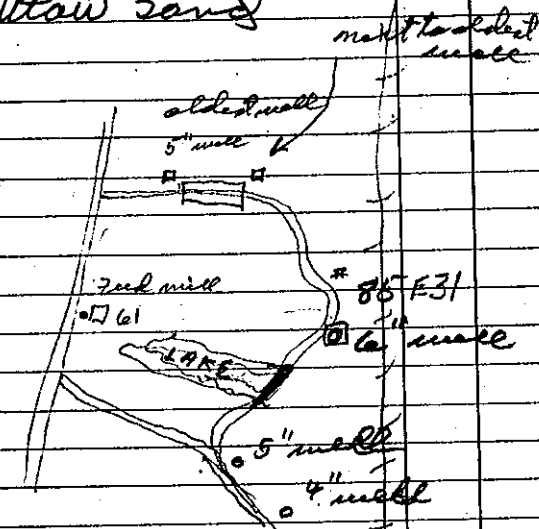

Information upon completion of well:

- (1) Diameter 6 inches.
- (2) Total Depth 500 feet.
- (3) Water Level 43 feet below top of ground.
- (4) Cased to 200, Size 6
- (5) Screen: Size 4, Length 40ft
- (6) Were any formations sealed against pollution?  
\_\_\_\_\_ yes, \_\_\_\_\_ no.

If YES depth of formation \_\_\_\_\_  
Why \_\_\_\_\_  
Drillers Remarks: \_\_\_\_\_

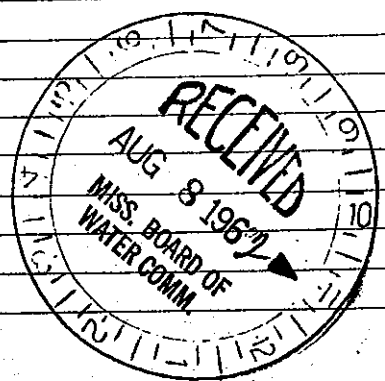

(Use Back Side)

85 ELEV 350

Well No.