

LEE MISSISSIPPI BOARD OF WATER COMMISSIONERS


E 33

2-3-64

WATER WELL DRILLERS LOG

Date: Feb 3, 1964, Driller: OTTIS Webb, JR County LEO
(Name)

(1) Owner of Land: <u>OTIS Van Landingham</u> (Name)	Description & Color of Materials Sand, Clay, Red Clay, Shell, etc.	Thick- ness Feet	Depth Feet		
<u>ham</u> (Address)	<u>Clay</u>	<u>0</u>	<u>30</u>		
(2) Location: <u>NW 1/4, SE 1/4, Sec. 5 T8R6</u> <u>1</u> miles <u>NW</u> , of <u>Saltville</u> (distance) (direction) (Nearest Town)	<u>Blue Sand & Marl</u>	<u>30</u>	<u>190</u>		
	<u>Blue Marl</u>	<u>190</u>	<u>375</u>		
	<u>Blue-grey Water Sand</u>	<u>375</u>	<u>504</u>		
(3) Topography: <u>Hilly</u> (Hilly) (Flat) (Level)					
(4) Purpose of Well: <u>Domestic</u> (Domestic Irrigation Municipal, Industrial, Other)					
Information upon completion of well:					
(1) Diameter <u>4</u> inches.					
(2) Total Depth <u>504</u> feet.					
(3) Water Level <u>80</u> feet below top of ground.					
(4) Cased to <u>211</u> , Size <u>4"</u>					
(5) Screen: Size _____, Length _____					
(6) Were any formations sealed against pollution? _____ yes, _____ no.					
If YES depth of formation _____					
Why _____					
Drillers Remarks: _____					
<u>9.2 ELEV 375</u>					

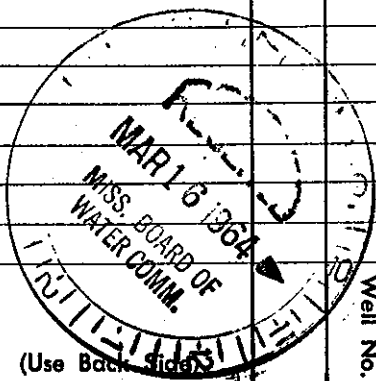

Well No.

(Use Back Side)

Mail this copy to Board of Water Commissioners 429 Miss. St. Jackson, Miss.