

LEE
~~B~~ E734
 7-18-61

MISSISSIPPI BOARD OF WATER COMMISSIONERS

WATER WELL DRILLERS LOG

Date: 7/16, 1961, Drilled by HERNDON WELL & SUPPLY CO county Lee



P. O. BOX 42
 SHANNON, MISSISSIPPI

	Description & Color of Materials Sand, Clay, Red Clay, Shell, etc.	Thick- ness Feet	Depth Feet
(1) Owner of Land: <u>Ray Parker</u> (Name) <u>Guntown, Miss.</u> (Address)	<u>Surface sand</u>		<u>0</u>
(2) Location: <u>NE 1/4, NW 1/4, Sec 30, T. 28 N., R. 6 E.</u> <u>1 1/2 miles South</u> of <u>Guntown</u> (distance) (direction) (Nearest Town)	<u>clay</u> <u>Blue rock</u>		<u>175</u>
(3) Topography: <u>Hilly</u> (Hilly) (Flat) (Level)	<u>Spud</u>		<u>320</u>
(4) Purpose of Well: <u>Domestic</u> (Domestic Irrigation Municipal, Industrial, Other)	<u>Bottom</u>		<u>440</u>

Information upon completion of well:

- (1) Diameter 4 inches.
- (2) Total Depth 440 feet.
- (3) Water Level 80 feet below top of ground.
- (4) Cased to 182', Size 4"
- (5) Screen: Size _____, Length _____
- (6) Were any formations sealed against pollution?
 yes, no.

If YES depth of formation 175 ft.
 Why surface sand
 Drillers Remarks: _____

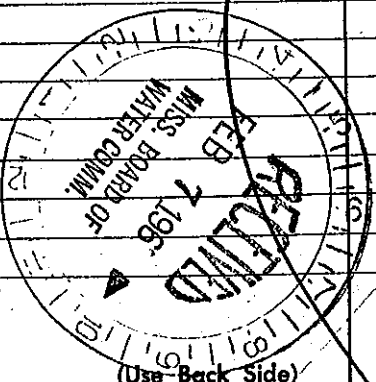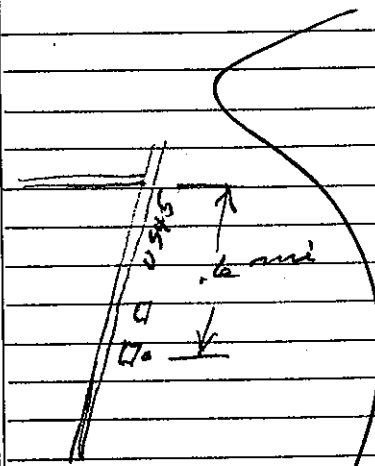

15 ✓ ELEV 375

Well No.