

Lee
E36
5-67 CODED

MISSISSIPPI BOARD OF WATER COMMISSIONERS

WATER WELL DRILLERS LOG

Date: 5-5, 1967, Driller: Herndon-Homan Well & Supply, Inc. County: Lee
(When well drilled) P. O. Box 42 SHANNON, MISSISSIPPI 38868 (Where well is located)

(1) Owner of Land: John Green
(Name)
Saltville Miss
(Address)
(2) Location: SE 1/4, SW 1/4, Sec. 8 T8 R6
1 1/2 miles NE of Saltville
(distance) (direction) (Nearest Town)
(3) Topography: flat
(Hilly) (Flat) (Level)
(4) Purpose of Well: Home
(Domestic Irrigation
Municipal, Industrial, Other)


Description & Color of Materials Sand, Clay, Red Clay, Shell, etc.	Thick- ness Feet	Depth Feet
<u>surface sand & clay</u>	<u>0</u>	<u>40</u>
<u>blue clay</u>	<u>40</u>	<u>70</u>
<u>sand</u>	<u>70</u>	<u>140</u>
<u>bottom</u>	<u>140</u>	

CODED

Information upon completion of well:

(1) Diameter 5 inches.
(2) Total Depth 140 feet.
(3) Water Level 50 feet below top of ground.
(4) Cased to 44' 5", Size 5"
(5) Screen: Size 100 #, Length _____
(6) Were any formations sealed against pollution?
✓ yes, _____ no.

If YES depth of formation 70'
Why surface and sand
Drillers Remarks: _____
Yield in gpm: _____
Size pump: by other
Type power: _____

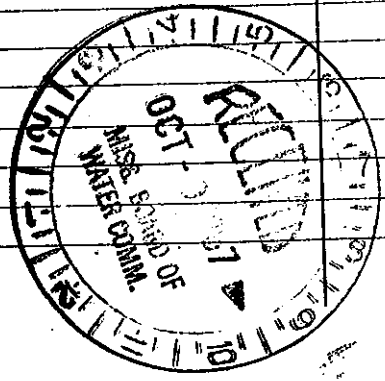

Retain this copy for your office files.