

LEE
E 39
4-23-62
CODED

MISSISSIPPI BOARD OF WATER COMMISSIONERS

WATER WELL DRILLERS LOG


Date: 4-23, 1962, Driller: O. C. Webb County Lee
(Name)

(1) Owner of Land:	Description & Color of Materials Sand, Clay, Red Clay, Shell, etc.	Thick- ness Feet	Depth Feet
(Name) <u>John Popymught</u> (Address) <u>Saltville Miss</u>	<u>Soil to 16ft</u> <u>sand + clay to</u> <u>200ft Blue marl</u> <u>to 350ft water</u> <u>Rock 6" water</u> <u>sand to 500</u> <u>ft water sand</u>		
(2) Location: <u>1/4, NE 1/4, Sec. 7 T8 R6E</u> <u>3</u> miles <u>North West</u> of <u>Saltville</u> (distance) (direction) (Nearest Town)			
(3) Topography: <input checked="" type="checkbox"/> (Hilly) <input type="checkbox"/> (Flat) <input type="checkbox"/> (Level)			
(4) Purpose of Well: <input checked="" type="checkbox"/> (Domestic Irrigation) <input type="checkbox"/> (Municipal, Industrial, Other)			

Information upon completion of well:

- (1) Diameter 4 inches.
- (2) Total Depth 500 feet.
- (3) Water Level 50 feet below top of ground.
- (4) Cased to 216, Size 4"
- (5) Screen: Size 0, Length 0
- (6) Were any formations sealed against pollution?
 yes, no.

If YES depth of formation _____
 Why _____
 Drillers Remarks: _____

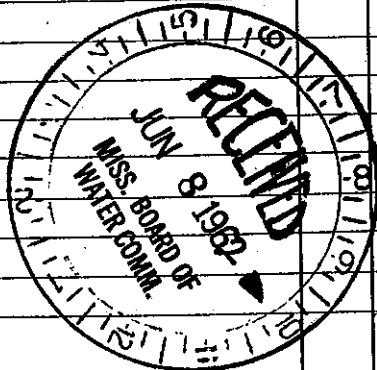

82 ✓

(Use Back Side)

Well No.