

Lee
E41
5-65

CODED

MISSISSIPPI BOARD OF WATER COMMISSIONERS

WATER WELL DRILLERS LOG

Date: May 27, 1965, Driller: Herndon-Homan Well & Supply, Inc.
(When well drilled) P. O. Box 42 Lee County
SHANNON, MISSISSIPPI 38868
(Name) (Where well is located)

(1) Owner of Land: Mid South Packer
(Name)
Sattilla, Miss
(Address)
 (2) Location: SE 1/4 NW 1/4, Sec. 9 T8 R6
1 miles N, of Sattilla
(distance) (direction) (Nearest Town)
 (3) Topography: rolling
(Hilly) (Flat) (Level)
 (4) Purpose of Well: feed lot
(Domestic Irrigation) (Municipal, Industrial, Other)

Description & Color of Materials Sand, Clay, Red Clay, Shell, etc.	Thick- ness Feet	Depth Feet
<u>surface sand & clay</u>	<u>18</u>	<u>18</u>
<u>blue clay</u>	<u>42</u>	<u>60</u>
<u>sand</u>	<u>80</u>	<u>140</u>
<u>blue clay</u>	<u>180</u>	<u>320</u>
<u>sand</u>	<u>467</u>	<u>467</u>
<u>Bottom</u>		<u>467</u>


southwest corner of pond

Information upon completion of well:

- (1) Diameter 4 inches.
- (2) Total Depth 467 feet.
- (3) Water Level 45 feet below top of ground.
- (4) Cased to 226', Size 4"
- (5) Screen: Size 40', Length 2"
- (6) Were any formations sealed against pollution?
 yes, no.

CODED

If YES depth of formation _____
 Why Surface & sand
 Drillers Remarks: 140'
 Yield in gpm: 20
 Size pump: 2 HP
 Type power: electric

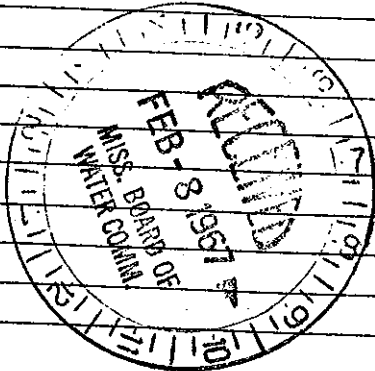

Mail this copy to Board of Water Commissioners 429 Miss. St. Jackson, Miss.
362