

Lee  
E42  
9-65

CODED  
MISSISSIPPI BOARD OF WATER COMMISSIONERS

**WATER WELL DRILLERS LOG**

Herndon-Homan Well & Supply, Inc.

Date: Sept 27, 1965, Driller: SHANNON, P. O. Box 42, County Lee  
(When well drilled) (Name) (Where well is located)


(1) Owner of Land:	Description & Color of Materials Sand, Clay, Red Clay, Shell, etc.	Thick- ness Feet	Depth Feet
<u>Bobby Turner</u> <small>(Name)</small> <u>Sallis, Miss</u> <small>(Address)</small>	<u>surface sand &amp; clay</u>	<u>0</u>	<u>40</u>
(2) Location: <u>SE 1/4, SE 1/4, Sec. 8, T5, R6E</u>	<u>Blue clay</u>	<u>40</u>	<u>60</u>
<u>1/2 miles N</u> , of <u>Sallis</u> <small>(distance) (direction) (Nearest Town)</small>	<u>Sand</u>	<u>60</u>	<u>140</u>
(3) Topography: <u>flat</u> <small>(Hilly) (Flat) (Level)</small>	<u>Blue clay bottom</u>	<u>140</u>	
(4) Purpose of Well: <u>Home</u> <small>(Domestic Irrigation Municipal, Industrial, Other)</small>			

Information upon completion of well:

(1) Diameter 4 inches.  
 (2) Total Depth 140 feet.  
 (3) Water Level 48' feet below top of ground.  
 (4) Cased to 42' 10", Size 4"  
 (5) Screen: Size none, Length \_\_\_\_\_  
 (6) Were any formations sealed against pollution?  
 yes,  no.

If YES depth of formation 40'  
 Why surface & sand  
 Drillers Remarks: \_\_\_\_\_  
 Yield in gpm: 3  
 Size pump: 1/2  
 Type power: Electric

Description & Color of Materials Sand, Clay, Red Clay, Shell, etc.	Thick- ness Feet	Depth Feet
<u>surface sand &amp; clay</u>	<u>0</u>	<u>40</u>
<u>Blue clay</u>	<u>40</u>	<u>60</u>
<u>Sand</u>	<u>60</u>	<u>140</u>
<u>Blue clay bottom</u>	<u>140</u>	

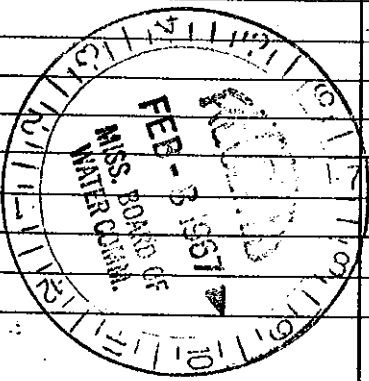

CODED

Mail this copy to Board of Water Commissioners 429 Miss. St. Jackson, Miss.  
368