

Lee
E43 CODED
10-65

MISSISSIPPI BOARD OF WATER COMMISSIONERS

WATER WELL DRILLERS LOG

Herndon-Homan Well & Supply, Inc.

Date: Oct 1, 1966, Driller: SHANNON, MISSISSIPPI 38868 County: Lee
(When well drilled) (Name) (Where well is located)


(1) Owner of Land: Ernest Webb
(Name)
Tropico, Miss
(Address)
 (2) Location: N 1/4, NE 1/4, Sec. 5, R. 3 E
1 1/2 miles N/E of Sattalo
(distance) (direction) (Nearest Town)
 (3) Topography: Flat
(Hilly) (Flat) (Level)
 (4) Purpose of Well: Domestic
(Domestic irrigation, Municipal, Industrial, Other)

Description & Color of Materials Sand, Clay, Red Clay, Shell, etc.	Thick- ness Feet	Depth Feet
<u>surface sand & clay</u>	<u>57</u>	<u>57</u>
<u>Blue clay</u>	<u>33</u>	<u>90</u>
<u>Sand</u>	<u>94</u>	<u>184</u>
<u>Blue clay</u>	<u>156</u>	<u>340</u>
<u>Sand</u>	<u>120</u>	<u>460</u>

Information upon completion of well:

(1) Diameter 4 inches.
 (2) Total Depth 460 feet.
 (3) Water Level 75 feet below top of ground.
 (4) Cased to 188', Size 4"
 (5) Screen: Size 20/42, Length _____
 (6) Were any formations sealed against pollution?
Yes, _____ no.

If YES depth of formation 184'
 Why surface & sand
 Drillers Remarks: _____
 Yield in gpm: 5
 Size pump: 1/3
 Type power: Electric

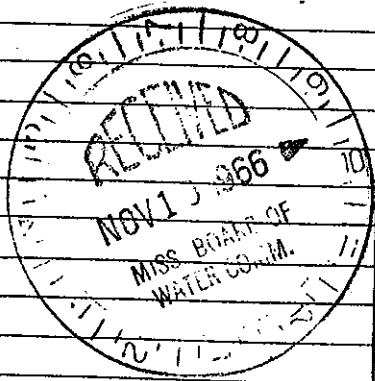

CODED

Mail this copy to Board of Water Commissioners 429 Miss. St. Jackson, Miss.
369