

Lee CODED
E45
9-66

MISSISSIPPI BOARD OF WATER COMMISSIONERS

WATER WELL DRILLERS LOG

Date: Sept 12, 1966, Driller: Herndon-Homan Well Supply, Inc.
(When well drilled) P. O. Box 42 County Lee
SHANNON, MISSISSIPPI 38868 (Where well is located)


(1) Owner of Land: Robert Pathe
(Name)
Saffill Miss.
(Address)
 (2) Location: NE 1/4 NW 1/4, Sec 17 T8 R6
1/4 miles N of Saffill
(distance) (direction) (Nearest Town)
 (3) Topography: rolling
(Hilly) (Flat) (Level)
 (4) Purpose of Well: Home
(Domestic Irrigation Municipal, Industrial, Other)

| Description & Color of Materials Sand, Clay, Red Clay, Shell, etc. | Thick- ness Feet | Depth Feet |
|---|------------------------|---------------|
| <u>surface sand & clay</u> | <u>45</u> | <u>45</u> |
| <u>blue clay</u> | <u>10</u> | <u>55</u> |
| <u>sand</u> | <u>75</u> | <u>130</u> |
| <u>blue clay</u> | <u>130</u> | |
| <u>Bottom</u> | | |

CODED

Information upon completion of well:

(1) Diameter 4 inches.
 (2) Total Depth 130 feet.
 (3) Water Level 55 feet below top of ground.
 (4) Cased to 48' 6", Size 4"
 (5) Screen: Size NONE, Length _____
 (6) Were any formations sealed against pollution?
 yes, _____ no.
 If YES depth of formation 45
 Why surface & sand
 Drillers Remarks: eg, others
 Yield in gpm: _____
 Size pump: _____
 Type power: _____

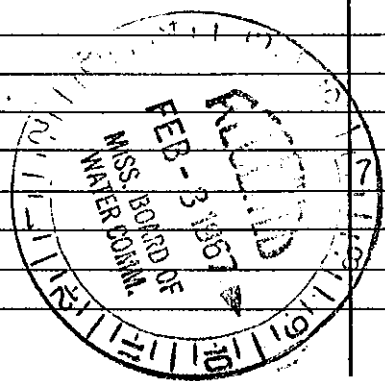

Mail this copy to Board of Water Commissioners 429 Miss. St. Jackson, Miss.