

LEE  
E51  
6-19-62

MISSISSIPPI BOARD OF WATER COMMISSIONERS


CODED

WATER WELL DRILLERS LOG

Date: 6/19, 1962, Driller: JAMES FOWLER County: LEE  
(Name)

	Description & Color of Materials Sand, Clay, Red Clay, Shell, etc.	Thick- ness Feet	Depth Feet
(1) Owner of Land: <u>Fomer Martin</u> (Name) <u>Battilo</u> (Address)			
(2) Location: <u>1/4</u> , <u>1/4</u> , Sec <u>20</u> T <u>5S</u> R <u>6E</u> <u>1/2</u> miles <u>SW</u> , of <u>Battilo</u> (distance) (direction) (Nearest Town)			
(3) Topography: <u>Hilly</u> (Hilly) (Flat) (Level)			
(4) Purpose of Well: <u>Domestic</u> (Domestic Irrigation Municipal, Industrial, Other)			
Information upon completion of well:			
(1) Diameter <u>4"</u> inches.			
(2) Total Depth _____ feet.			
(3) Water Level <u>30'</u> feet below top of ground.			
(4) Cased to <u>5</u> , Size <u>4"</u>			
(5) Screen: Size _____, Length _____			
(6) Were any formations sealed against pollution? _____ yes, _____ no.			
If YES, depth of formation _____			
Why _____			
Drillers Remarks: _____			
<u>Contract signed</u>			
<u>86</u>			

CODED

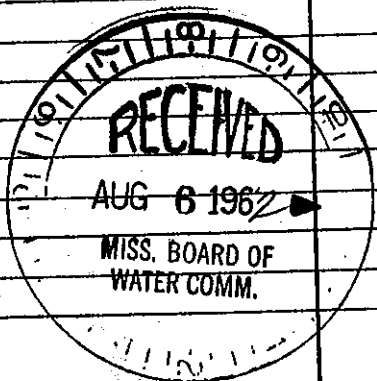

(Use Back Side)

Well No.