

LEE 5  
 3/25  
 E52

Date: 3/25, 1962, Driller: James Lee, LBE

(Name)

3-23-62  
 (1) Owner of Land: Calvin Turner

(Name)

Saltillo

(Address)

(2) Location: E 1/4, Sec. 22, T5R1E

1 miles E of Saltillo

(distance)

(direction)

(Nearest Town)

(3) Topography: Hilly

(Hilly)

(Flat)


(Level)

(4) Purpose of Well: Domestic

(Domestic Irrigation, Municipal, Industrial, Other)

Description & Color of Materials Sand, Clay, Red Clay, Shell, etc.	Thick- ness Feet	Depth Feet
sand	30'	
blue clay	20'	
sand	50'	
blue clay	150'	
sand	120'	

SALTILLO

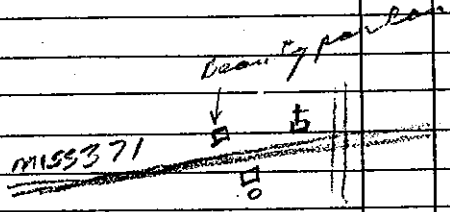


Information upon completion of well:

- (1) Diameter 4" inches.
- (2) Total Depth 470' feet.
- (3) Water Level 90' feet below top of ground.
- (4) Cased to 209', Size 4"
- (5) Screen: Size \_\_\_\_\_, Length \_\_\_\_\_.
- (6) Were any formations sealed against pollution?  
 yes, \_\_\_\_\_ no.

If YES depth of formation \_\_\_\_\_

Why \_\_\_\_\_

Drillers Remarks: \_\_\_\_\_

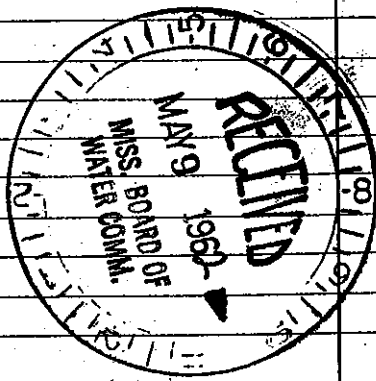

(Use Back Side)

Well No.

81

Mail this copy to Board of Water Commissioners 429 Miss. St. Jackson, Miss.