

LEE
E 53 CODED
7-11-66

MISSISSIPPI BOARD OF WATER COMMISSIONERS

WATER WELL DRILLERS LOG

E309

Date: 7/11, 1966, Driller: HERNDON WELL & SUPPLY CO. County Lee
P. O. BOX 42
SHANNON, MISSISSIPPI


| (1) Owner of Land: | Description & Color of Materials Sand, Clay, Red Clay, Shell, etc. | Thick- ness Feet | Depth Feet |
|---|---|------------------------|---------------|
| <u>Travis Cartwright</u> (Name) <u>Sattilla, Miss</u> (Address) | <u>Surface Sand & Clay</u> | | <u>0</u> |
| (2) Location: <u>1/4</u> , <u>1/4</u> , Sec. <u>17</u> T. <u>8 S</u> R. <u>6 E</u> <u>1</u> miles <u>W</u> of <u>Sattilla</u> (distance) (direction) (Nearest Town) | <u>Blue water</u> | <u>195</u> | |
| (3) Topography: <u>Hilly</u> (Hilly) (Flat) (Level) | <u>Sand</u> | <u>3 7/8</u> | |
| (4) Purpose of Well: <u>Domestic</u> (Domestic Irrigation Municipal, Industrial, Other) | <u>Bottom</u> | <u>460</u> | |

Information upon completion of well:

- (1) Diameter 4 inches.
- (2) Total Depth 460 feet.
- (3) Water Level 90 feet below top of ground.
- (4) Cased to 199', Size 4"
- (5) Screen: Size _____, Length _____.
- (6) Were any formations sealed against pollution?
 yes, _____ no.

If YES depth of formation 195'
 Why Surface & sand
 Drillers Remarks: Can see from MW 45
his home - colonial

79

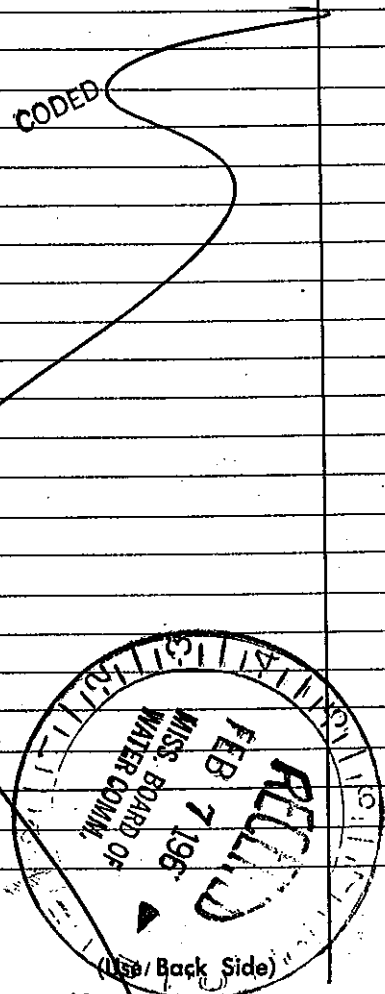

Well No.