

MISSISSIPPI BOARD OF WATER COMMISSIONERS

LEE  
E54  
5-15-61  
CODED

WATER WELL DRILLERS LOG  
HERNDON WELL & SUPPLY CO.

E309

Date: May 15, 1961, Driller: SHANNON, MISSISSIPPI County Lee  
(Name)

P. O. BOX 42

(1) Owner of Land: Travis Cartwright  
(Name)  
Scottville, Miss.  
(Address)

(2) Location: 1/4, 1/4, Sec 20, T. 85, R. 6E  
1 miles — of Scottville  
(distance) (direction) (Nearest Town)

(3) Topography: Hilly  
(Hilly) (Flat) (Level)

(4) Purpose of Well: Home use  
(Domestic Irrigation  
Municipal, Industrial, Other)

Description & Color of Materials Sand, Clay, Red Clay, Shell, etc.	Thick- ness Feet	Depth Feet
<u>Surface sand</u>		<u>0</u>
<u>Clay</u>		
<u>White rock</u>		<u>195</u>
<u>sand</u>		<u>340</u>
<u>Bottom</u>		<u>460</u>

Information upon completion of well:

(1) Diameter 4 inches.

(2) Total Depth 460 feet.

(3) Water Level 75 feet below top of ground.

(4) Cased to 200' 5", Size 4"


(5) Screen: Size —, Length —

(6) Were any formations sealed against pollution?  
 yes,  no.

If YES depth of formation 195'

Why Surface + sand

Drillers Remarks: Cartwright  
subdivision

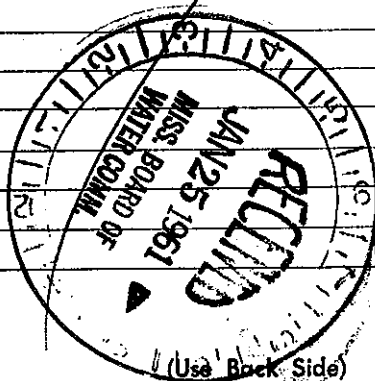

Well No.