

MISSISSIPPI BOARD OF WATER COMMISSIONERS

LEE
E56
9-17-60 CODED

6304

WATER WELL DRILLERS LOG

Herndon Well & Supply Co.
SHANNON, MISS. County Lee

Date: Sept 17, 1960, Driller: _____ (Name)

	Description & Color of Materials Sand, Clay, Red Clay, Shell, etc.	Thick- ness Feet	Depth Feet
(1) Owner of Land: <u>O.H. Richardson</u> (Name) <u>Sallito, Mississippi</u> (Address)	<u>Sand & Clay</u>		<u>189</u>
(2) Location: _____ 1/4, _____ 1/4, Sec <u>21</u> T <u>8</u> R <u>6</u> _____ miles _____, of <u>Sallito</u> (distance) (direction) (Nearest Town)	<u>Blue Rock</u> <u>Sand</u> <u>Bottom</u>	<u>294</u>	<u>420</u>
(3) Topography: <u>Hilly</u> (Hilly) (Flat) (Level)			
(4) Purpose of Well: <u>Home Use</u> (Domestic Irrigation Municipal, Industrial, Other)			

CODED

Information upon completion of well:


- (1) Diameter 4 inches.
- (2) Total Depth 420 feet.
- (3) Water Level 55 feet below top of ground.
- (4) Cased to 189 ft Size 4"
- (5) Screen: Size _____, Length _____
- (6) Were any formations sealed against pollution?
 yes, _____ no.

If YES depth of formation 185 ft

Why Surface & Sand

Drillers Remarks: for 5th house

on right hand of street

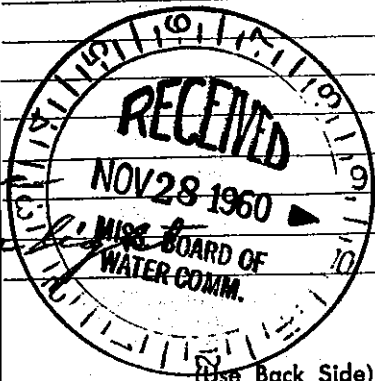

Well No.

Mail this copy to Board of Water Commissioners 429 Miss. St. Jackson, Miss