

MISSISSIPPI BOARD OF WATER COMMISSIONERS

LEE
E59 WATER WELL DRILLERS LOG

7-5-60

Herndon Well & Supply Co.

E302

Date: July 5, 1960, Driller: SHANNON, MISS. County Lee

(Name)

(1) Owner of Land: Travis Carter
(Name)
Saltville, Mississippi
(Address)

(2) Location: 1/4, 1/4, Sec. 20 T6R6
0 miles S of Saltville
(distance) (direction) (Nearest Town)

(3) Topography: Hills
(Hilly) (Flat) (Level)

(4) Purpose of Well: Home use
(Domestic Irrigation
Municipal, Industrial, Other)

Description & Color of Materials Sand, Clay, Red Clay, Shell, etc.	Thick- ness Feet	Depth Feet
<u>Sand & Clay</u>	<u>5</u>	<u>212</u>
<u>Blue Block</u>	<u>1</u>	<u>212</u>
<u>Sand</u>	<u>5</u>	<u>320</u>
<u>Bottom</u>		<u>462</u>

Information upon completion of well:

(1) Diameter 4 inches.

(2) Total Depth 462 feet.

(3) Water Level 70 feet below top of ground.

(4) Cased to 212' 8", Size 4"


(5) Screen: Size —, Length —

(6) Were any formations sealed against pollution?
X yes, — no.

If YES depth of formation 212' 8"

Why Surface 2 sand

Drillers Remarks: near subdivision in SW part of town

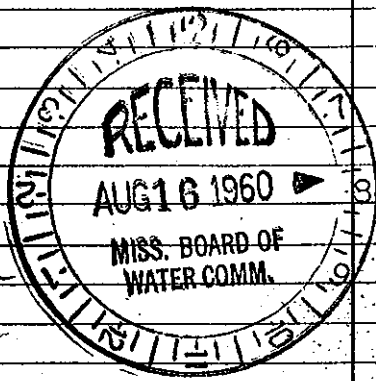

(Use Back Side)

Well No. E302

Mail this copy to Board of Water Commissioners 429 Miss. St. Jackson, Miss