

LEE

E84

3-12-74

E Log #72

3/12/74

MISSISSIPPI BOARD OF WATER COMMISSIONERS 416 North State Street Jackson, Mississippi 39201

CODED

WATER WELL DRILLERS LOG

Herndon Well & Supply

Lee

date well completed

firm name

county well located

LANDOWNER: Lee Co. Board of Supervisors, TURNER INDUSTRIAL PARK Tupelo, Miss. 38801 (mailing address)


WELL LOCATION: sec 29 T 9 S R 6 E 2 miles SW of Saltillo (distance) (direction) (nearest town)

WELL PURPOSE: Industrial (home, irrigation, municipal, industrial)

- WELL COMPLETION DATA: (1) diameter (inches) 12 x 8 (2) total depth (feet) 520 (3) static water level (feet) 138 below top of ground. (4) casing Steel 440' (material) (depth) 12 (size) If telescope see back. (5) screen 60' (length) (depth to top) 8 S S (size) (material) (6) pump 50 (HP) 381 (yield gpm) Elec. (type power) (7) electric log yes (yes or no) USGS (organization running log) (8) how well bottom plugged 8" Brass BW

Table with 4 columns: description of formations encountered, from, to. Rows include Red Sand, White Sand, Blue Rock, Fine Sand, Rock, Tight Sand, Blue Rock Sand, Lime Rock Sand, Tight Sand, Gravel.

CODED

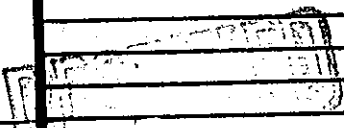

MAY 18 1974

MISS. BD. OF WATER COMM

DRILLERS REMARKS: