

MISSISSIPPI BOARD OF WATER COMMISSIONERS

WATER WELL DRILLERS LOG

HERNDON WELL & SUPPLY CO.

P. O. BOX 42 County Lee  
SHANNON, MISSISSIPPI

LEE  
E 2002  
5-19-61

F302

Date: May 15, 1961, Driller:

(1) Owner of Land: Homer Harvised  
(Name)  
Rt 2 Canton, Miss.  
(Address)  
(2) Location: SE 1/4, NE 1/4, Sec. 22, T. 85 N, R. 7 E  
10 miles west, of Scott  
(distance) (direction) (Nearest Town)  
(3) Topography: Hilly  
(Hilly) (Flat) (Level)  
(4) Purpose of Well: Home use  
(Domestic Irrigation  
Municipal, Industrial, Other)

Description & Color of Materials Sand, Clay, Red Clay, Shell, etc.	Thick- ness Feet	Depth Feet
Surface SAND + clay	0	
Blue rock	17	
SAND	8	120
Bottom	8	240


Information upon completion of well:

(1) Diameter 4 inches.  
(2) Total Depth 240 feet.  
(3) Water Level 95 feet below top of ground.  
(4) Cased to 22', Size 4"  
(5) Screen: Size \_\_\_\_\_, Length \_\_\_\_\_  
(6) Were any formations sealed against pollution?  
yes, \_\_\_\_\_ no.

If YES depth of formation 20

Why Surface & sand

Drillers Remarks:

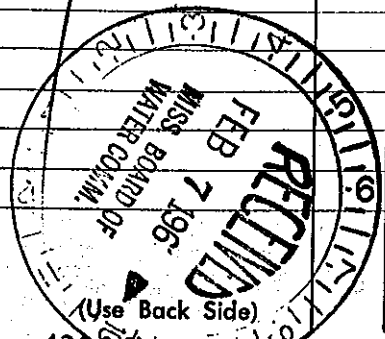

Well No.