

Lee
E 2004
7-66

MISSISSIPPI BOARD OF WATER COMMISSIONERS

WATER WELL DRILLERS LOG

Date: 7/28, 1966, Driller: Ewing Sacco County Lee
(Name)


(1) Owner of Land: Walter Sacco
(Name) Daltillo Rd
(Address)
(2) Location: 3/4, 1/4, Sec. 36 T85R26
3 miles SW of Daltillo
(distance) (direction) (Nearest Town)
(3) Topography: Hilly
(Hilly) (Flat) (Level)
(4) Purpose of Well: Domestic
(Domestic Irrigation
Municipal, Industrial, Other)

Description & Color of Materials Sand, Clay, Red Clay, Shell, etc.	Thick- ness Feet	Depth Feet
<u>Hard Clay</u>	<u>0</u>	<u>80</u>
<u>Blue Clay</u>	<u>80</u>	<u>110</u>
<u>3 in. Sand & clay</u>	<u>110</u>	<u>160</u>
<u>Sand & Blue clay</u>	<u>160</u>	<u>350</u>
<u>Sand</u>	<u>350</u>	<u>514</u>

Information upon completion of well:

(1) Diameter 4 inches.
(2) Total Depth 514 feet.
(3) Water Level 130 feet below top of ground.
(4) Cased to 165 ft, Size 4 in.
(5) Screen: Size _____, Length _____.
(6) Were any formations sealed against pollution?
_____ yes, _____ no.

If YES depth of formation _____
Why _____
Drillers Remarks: _____

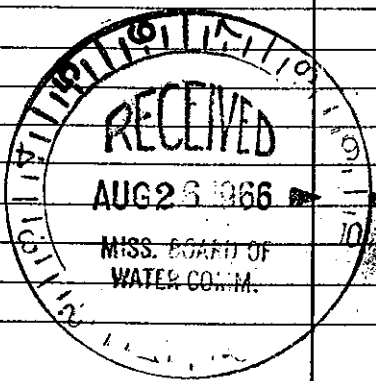

(Use Back Side)

Well No.

Mail this copy to Board of Water Commissioners 429 Miss. St. Jackson, Miss