


Lee  
E 2005  
8-66

MISSISSIPPI BOARD OF WATER COMMISSIONERS

WATER WELL DRILLERS LOG

Date: 8/27, 1966, Driller: L. W. Wingo County Lee  
(Name)

(1) Owner of Land:	Description & Color of Materials Sand, Clay, Red Clay, Shell, etc.	Thick- ness Feet	Depth Feet
<u>Daisy Sandlin</u> (Name)	<u>Hard clay</u>	<u>0</u>	<u>15</u>
<u>D. L. Tills</u> (Address)	<u>Blue</u>	<u>15</u>	<u>200</u>
(2) Location: <u>1/4</u> , <u>1/4</u> , Sec <u>20</u> T <u>8</u> R <u>6</u>	<u>Sand</u>	<u>200</u>	<u>371</u>
<u>1</u> miles <u>S</u> , of <u>Daltills</u> (distance) (direction) (Nearest Town)			
(3) Topography: <u>Flat</u> (Hilly) (Flat) (Level)			
(4) Purpose of Well: (Domestic Irrigation Municipal, Industrial, Other)			
Information upon completion of well:			
(1) Diameter <u>4</u> inches.			
(2) Total Depth <u>371</u> feet.			
(3) Water Level <u>41</u> feet below top of ground.			
(4) Cased to <u>210'</u> , Size <u>4 in</u> .			
(5) Screen: Size _____, Length _____.			
(6) Were any formations sealed against pollution?			
_____ yes, _____ no.			
If YES depth of formation _____			
Why _____			
Drillers Remarks: _____			
_____			
_____			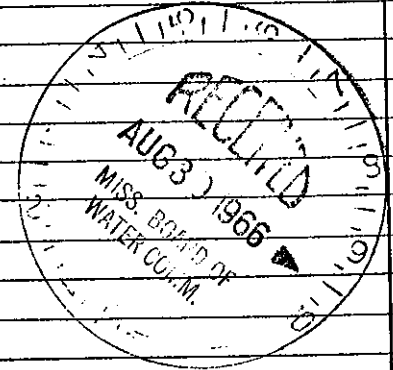
Well No.

(Use Back Side)

Mail this copy to Board of Water Commissioners 429 Miss. St. Jackson, Miss.