

Lee  
E  
7-66 2006

MISSISSIPPI BOARD OF WATER COMMISSIONERS

WATER WELL DRILLERS LOG


Date: 7/13, 1966, Driller: Giving Gas Co. County Lee  
(Name)

(1) Owner of Land	Description & Color of Materials Sand, Clay, Red Clay, Shell, etc.	Thick- ness Feet	Depth Feet
<u>Carrington</u> (Name)	<u>Very Sand &amp; Clay</u>	<u>0</u>	<u>80</u>
<u>Saltillo Rt. 1</u> (Address)	<u>Blue Clay</u>	<u>80</u>	<u>170</u>
(2) Location: <u>21</u> <u>3</u> <u>6</u> <u>SE</u> <u>1</u> T. R. S. E. Sec.	<u>Very Sand &amp; Clay</u>	<u>110</u>	<u>162</u>
<u>3</u> miles <u>SE</u> of <u>Saltillo</u> (distance) (direction) (Nearest Town)	<u>Blue Clay</u>	<u>162</u>	<u>190</u>
<u>3</u> miles <u>SE</u> of <u>Saltillo</u> (distance) (direction) (Nearest Town)	<u>Sand</u>	<u>190</u>	<u>440</u>
(3) Topography: <u>Hilly</u> (Hilly) (Flat) (Level)			
(4) Purpose of Well: <u>Domestic</u> (Domestic Irrigation Municipal, Industrial, Other)			

Information upon completion of well:

- (1) Diameter 6 inches.
- (2) Total Depth 434 feet.
- (3) Water Level 153 feet below top of ground.
- (4) Cased to 175 ft., Size 6 in.
- (5) Screen: Size 4 in., Length 10 ft.
- (6) Were any formations sealed against pollution?  
yes, no.

If YES depth of formation \_\_\_\_\_  
Why \_\_\_\_\_  
Drillers Remarks: \_\_\_\_\_

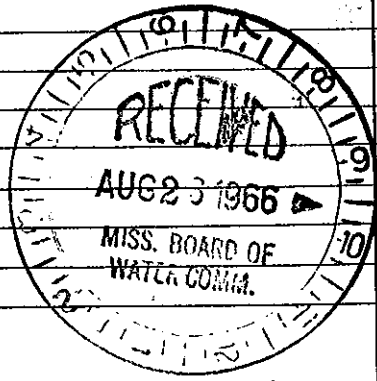

(Use Back Side)

Well No.

Mail this copy to Board of Water Commissioners 429 Miss. St. Jackson, Miss