

Lee
E 2007
6-66

MISSISSIPPI BOARD OF WATER COMMISSIONERS

WATER WELL DRILLERS LOG

Date: 6/29, 1966, Driller: Gering Bros. Co. County Get
(Name)

(1) Owner of Land: TK Douglas
(Name)
Ballitts Pt.
(Address)

(2) Location: 2 1/4 Sec. 21 T8 R6
3 miles SE of Ballitts
(distance) (direction) (Nearest Town)

(3) Topography: Killy
(Hilly) (Flat) (Level)

(4) Purpose of Well: Domestic
(Domestic Irrigation
Municipal, Industrial, Other)

Description & Color of Materials Sand, Clay, Red Clay, Shell, etc.	Thick- ness Feet	Depth Feet
<u>mix sand & clay</u>	<u>0</u>	<u>80</u>
<u>blue clay</u>	<u>80</u>	<u>110</u>
<u>mix sand & clay</u>	<u>110</u>	<u>162</u>
<u>blue clay</u>	<u>162</u>	<u>190</u>
<u>mix sand & blue</u>	<u>190</u>	<u>300</u>
<u>sand</u>	<u>300</u>	<u>440</u>

Information upon completion of well:

(1) Diameter 4 inches.

(2) Total Depth 414 feet.

(3) Water Level 135 feet below top of ground.

(4) Cased to 185 ft., Size 4 in.


(5) Screen: Size _____, Length _____.

(6) Were any formations sealed against pollution?
yes

If YES depth of formation lime water

Why lime water

Drillers Remarks: _____

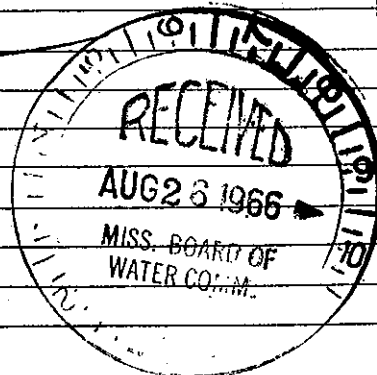

Well No.

(Use Back Side)

Mail this copy to Board of Water Commissioners 429 Miss. St. Jackson, Miss.