

See
E
8-662008

MISSISSIPPI BOARD OF WATER COMMISSIONERS

WATER WELL DRILLERS LOG

Date: 8/26, 1966, Driller: Ewingbasco, County: Bell
(Name)

(1) Owner of Land: Jones, Eugene
(Name)
Sumner Rd. 1
(Address)

(2) Location: 3 1/4, S 1/4, Sec 3 T 8 R 6
3 miles S of Sumner
(distance) (direction) (Nearest Town)

(3) Topography: Hilly
(Hilly) (Flat) (Level)

(4) Purpose of Well: Domestic
(Domestic Irrigation
Municipal, Industrial, Other)

Description & Color of Materials Sand, Clay, Red Clay, Shell, etc.	Thick- ness Feet	Depth Feet
<u>Joint Clay</u>	<u>0</u>	<u>50</u>
<u>Blue Clay</u>	<u>30</u>	<u>80</u>
<u>Sand</u>	<u>120</u>	<u>200</u>
<u>Blue</u>	<u>170</u>	<u>270</u>
<u>Sand</u>	<u>275</u>	<u>414</u>

Information upon completion of well:

(1) Diameter 4 inches.

(2) Total Depth 414 feet.

(3) Water Level 120 feet below top of ground.

(4) Cased to 183 ft., Size 4 in.


(5) Screen: Size _____, Length _____.

(6) Were any formations sealed against pollution?
_____ yes, _____ no.

If YES depth of formation _____

Why _____

Drillers Remarks: _____

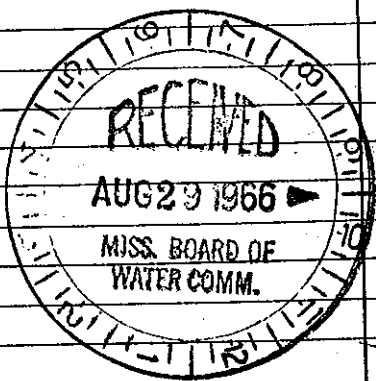

Well No.

(Use Back Side)