

Lee
E 2009
8-67

MISSISSIPPI
BOARD OF WATER COMMISSIONERS
416 North State Street
Jackson, Mississippi 39201
WATER WELL DRILLERS LOG


8-10-1967 Ewing Gas Co LEE
date well completed firm name county well located

LANDOWNER: DOMA AUSTRIAN description of formations encountered from to
SATTILA MISS (mailing address) CLAY 0 16
SAND 16 104
BLUE 104 250

WELL LOCATION:
sec. 14 T. 25 N. R. 6 E
S W
4 miles S.W. of SATTILA
(distance) (direction) (nearest town)

WELL PURPOSE: Home
(home, irrigation, municipal, industrial)

- WELL COMPLETION DATA:
- (1) diameter (inches) 4"
 - (2) total depth (feet) 250'
 - (3) static water level (feet) 120' below above top of ground.
 - (4) casing CT 90'
(material) (depth)
(size) If telescope see back.
 - (5) screen _____ (length) _____ (depth to top)
(size) _____ (material)
 - (6) pump 3/4 825
(HP) (yield gpm)
(type power) EL
 - (7) electric log no
(yes or no)
(organization running log)
 - (8) how well bottom plugged open

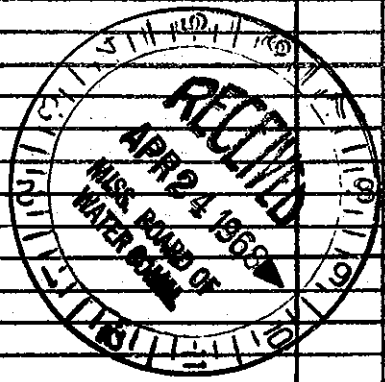

DRILLERS REMARKS: