

LEE

MISSISSIPPI BOARD OF WATER COMMISSIONERS

F  
5-16-61

WATER WELL DRILLERS LOG

F307

HERNDON WELL & SUPPLY CO.

Date: May 16, 1961, Driller: SHANNON, MISSISSIPPI P. O. BOX 42 County Lee

(Name)

	Description & Color of Materials Sand, Clay, Red Clay, Shell, etc.	Thick- ness Feet	Depth Feet
(1) Owner of Land: <u>Charles Brooks</u> (Name) <u>Rt 2 Canton, Miss</u> (Address)	<u>Surface sand &amp; clay</u>		<u>0</u>
(2) Location: <u>1/4, 1/4, Sec 22 T 45 R 7E</u> <u>10 miles East of Slatton</u> (distance) (direction) (Nearest Town)	<u>Blue rock sand &amp;</u>	<u>70</u>	<u>140</u>
(3) Topography: <u>Hilly</u> (Hilly) (Flat) (Level)	<u>Bottom</u>	<u>260</u>	
(4) Purpose of Well: <u>Home use</u> (Domestic Irrigation Municipal, Industrial, Other)			

Information upon completion of well:


- (1) Diameter 4 inches.
- (2) Total Depth 260 feet.
- (3) Water Level 105 feet below top of ground.
- (4) Cased to 22'8", Size 4"
- (5) Screen: Size \_\_\_\_\_, Length \_\_\_\_\_
- (6) Were any formations sealed against pollution?  
 yes,  no.

If YES depth of formation 20 ft

Why Surface & SAND

Drillers Remarks:

957

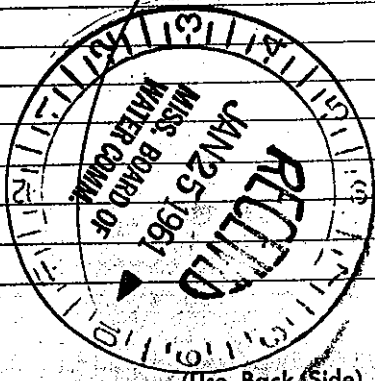

(Use Back Side)

Well No