

LEE MISSISSIPPI BOARD OF WATER COMMISSIONERS

F 9

5-30-62

CODED WATER WELL DRILLERS LOG


Date: 5/30, 1962, Driller: James Fowler County Lee
(Name)

(1) Owner of Land: <u>Mrs Jack Perrins</u> <small>(Name)</small>	Description & Color of Materials Sand, Clay, Red Clay, Shell, etc.	Thick- ness Feet	Depth Feet
<u>Salt Hills RT. 2</u> <small>(Address)</small>			
(2) Location: <u>1/4</u> , <u>1/4</u> , Sec. <u>16</u> T. <u>8</u> R. <u>7</u> , <u>8</u> miles <u>E</u> , of <u>SALT HILLS</u> <small>(distance) (direction) (Nearest Town)</small>			
(3) Topography: <u>Kelly</u> <small>(Hilly) (Flat) (Level)</small>			
(4) Purpose of Well: <u>Domestic</u> <small>(Domestic Irrigation Municipal, Industrial, Other)</small>			

Information upon completion of well:

- (1) Diameter 4" inches.
- (2) Total Depth 264' feet.
- (3) Water Level 90' feet below top of ground.
- (4) Cased to 21'-7", Size 4"
- (5) Screen: Size _____, Length _____
- (6) Were any formations sealed against pollution?
 yes, no.

If YES depth of formation _____
 Why _____
 Drillers Remarks: _____

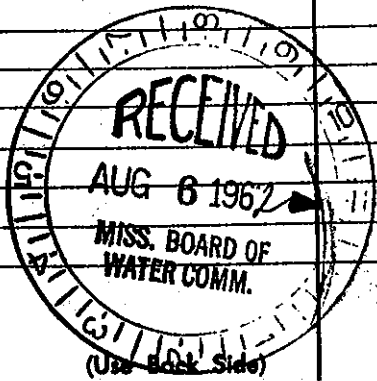

Well No. _____