

LEE
F10
10-67

MISSISSIPPI
BOARD OF WATER COMMISSIONERS
416 North State Street
Jackson, Mississippi 39201

CODED

WATER WELL DRILLERS LOG

10/2 1967 Horton-Homan Well & Supply, Inc. Lee
date well completed 1967 Box 42 county well located
ANDALUSIA, MISSISSIPPI 39008


LANDOWNER:
O. S. Rapel
PO 1 Guntown, Miss
(mailing address)

description of formations encountered	from	to
<u>surface sand clay</u>	<u>0</u>	<u>35</u>
<u>blue clay</u>	<u>35</u>	<u>120</u>
<u>sand</u>	<u>120</u>	<u>240</u>
<u>bottom</u>	<u>240</u>	

WELL LOCATION:
sec. 10 T. 8 N. R. 7 E.
S. W. N. E.
7 miles E of Sattilo
(distance) (direction) (nearest town)

WELL PURPOSE: Home
(home, irrigation, municipal, industrial)

- WELL COMPLETION DATA:
- (1) diameter (inches) 5"
 - (2) total depth (feet) 240
 - (3) static water level (feet) 67 ^{below} above top of ground.
 - (4) casing steel, 39'5"
(material) (depth)
 if telescope see back.
(size)
 - (5) screen NONE
(length) (depth to top)
 (size) (material)
 - (6) pump 3/4 5
(HP) (yield gpm)
Electric
(type power)
 - (7) electric log NO
(yes or no)
 (organization running log)
 - (8) how well bottom plugged open

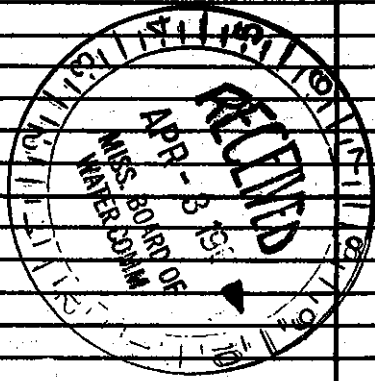

DRILLERS REMARKS: