

LEE MISSISSIPPI BOARD OF WATER COMMISSIONERS

G 16
7-1-60

WATER WELL DRILLERS LOG

G-300

Herndon Well & Supply Co.

Date: July 1, 1960, Driller: SHANNON, MISS. County: Lee

(Name)


(1) Owner of Land: Shelby Stifford
(Name)
P.O. Box Tupelo, Miss
(Address)
28
(2) Location: 1/4, 1/4, Sec. 33 T. 9 S.
4 miles West, of Tupelo
(distance) (direction) (Nearest Town)
(3) Topography: Flat
(Hilly) (Flat) (Level)
(4) Purpose of Well: Home Use
(Domestic Irrigation
Municipal, Industrial, Other)

Description & Color of Materials Sand, Clay, Red Clay, Shell, etc.	Thick- ness Feet	Depth Feet
Sand and Clay		281
Blue Rock		281
Sand		300
Bottom		580
Red pumpage 3/4 H.P.		

Information upon completion of well:

- (1) Diameter 4 inches.
- (2) Total Depth 580 feet.
- (3) Water Level 130 feet below top of ground.
- (4) Cased to 560, Size 4" x 2"
- (5) Screen: Size 2", Length 20 ft.
- (6) Were any formations sealed against pollution?
 yes, no.

If YES depth of formation 281 ft.
Why surface of sand
Drillers Remarks: cased to 281 ft
with 4" of pipe then
to 560 with 2"
97 ELEV 340

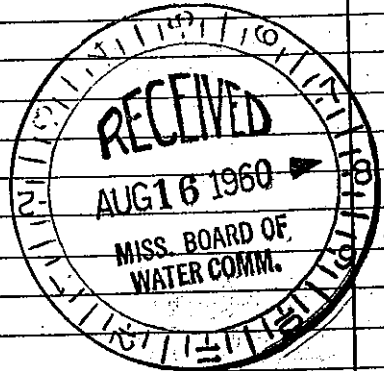

Well No.
G 300

(Use Back Side)

Mail this copy to Board of Water Commissioners 429 Miss. St. Jackson, Miss.