

LEE

MISSISSIPPI BOARD OF WATER COMMISSIONERS


G 18


WATER WELL DRILLERS LOG

11-8-60

Date: Nov 8 1960, Driller: O.C. Webb County Lee

(Name)

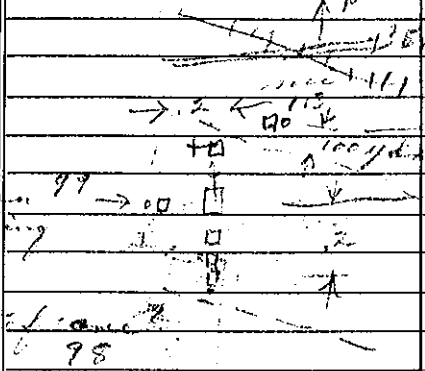(1) Owner of Land:	Description & Color of Materials Sand, Clay, Red Clay, Shell, etc.	Thick- ness Feet	Depth Feet
(Name) <u>Roh Gasana</u> (Address) <u>Belden Miss</u>	<u>soil to 15 ft</u>		
(2) Location: <u>SE 1/4, NE 1/4, Sec. 17 T. 9 R. 5</u> <u>1</u> miles <u>west</u> of <u>Belden</u> (distance) (direction) (Nearest Town)	<u>Blue marl 155 ft</u> <u>Hard rock 2 ft</u> <u>55 ft water sand</u> <u>coffee</u>		
(3) Topography: <u>level</u> (Hilly) (Flat) (Level)			
(4) Purpose of Well: <u>Domestic Irrigation</u> (Domestic Irrigation, Municipal, Industrial, Other)			
Information upon completion of well:			
(1) Diameter <u>4</u> inches.			
(2) Total Depth <u>210</u> feet.			
(3) Water Level <u>70</u> feet below top of ground.			
(4) Cased to <u>20 ft</u> , Size <u>4"</u>			
(5) Screen: Size <u>70</u> , Length _____			
(6) Were any formations sealed against pollution? _____ yes, _____ no.			
If YES depth of formation _____			
Why _____			
Drillers Remarks: <u>Teaching school</u>			
<u>99 ELEV 355</u>			

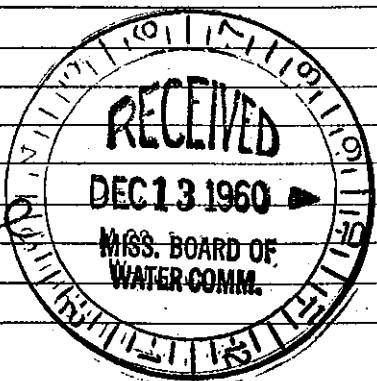

(Use Back Side)

Well No.

Mail this copy to Board of Water Commissioners 429 Miss. St. Jackson, Miss