

LEE

MISSISSIPPI BOARD OF WATER COMMISSIONERS

G 23

6-62

WATER WELL DRILLERS LOG

Date: 6/19/62, Driller: James J. ... County: Lee

(Name)

(1) Owner of Land: James Moran (Name)
Supho ... (Address)

(2) Location: 1/4, 1/4, Sec 35 T28N R7E
4 miles W of Supho (distance, direction, Nearest Town)

(3) Topography: Hilly (Hilly) (Flat) (Level)


(4) Purpose of Well: Domestic (Domestic Irrigation, Municipal, Industrial, Other)

Table with 3 columns: Description & Color of Materials (Sand, Clay, Red Clay, Shell, etc.), Thickness (Feet), Depth (Feet). Contains handwritten entries and a large circular stamp.

Information upon completion of well:

- (1) Diameter 4 inches.
(2) Total Depth 621 feet.
(3) Water Level 139.0 feet below top of ground.
(4) Cased to 21 feet, Size 4 inches.
(5) Screen: Size, Length.
(6) Were any formations sealed against pollution? yes, no.

If YES depth of formation
Why
Drillers Remarks: Sub < 1

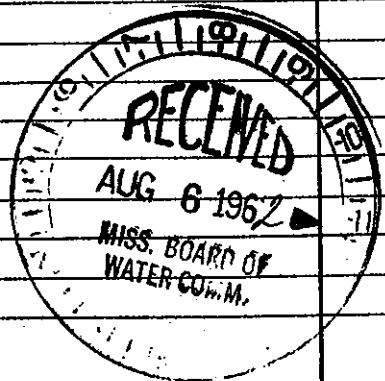

107 ELEV 340

(Use Back Side)

Well No.

Mail this copy to Board of Water Commissioners 429 Miss. St. Jackson, Miss.