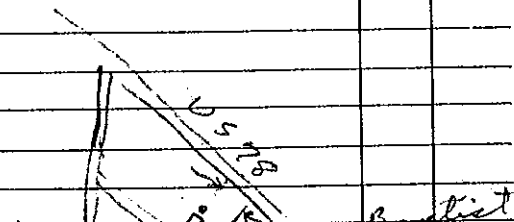


LEE
G 25
8-30-62

MISSISSIPPI BOARD OF WATER COMMISSIONERS

WATER WELL DRILLERS LOG

Date: Aug 30, 1962, Driller: Otto Webb, Jr. County Lee
Frank Lawrence (1967) (Name)

(1) Owner of Land:	Description & Color of Materials Sand, Clay, Red Clay, Shell, etc.	Thick- ness Feet	Depth Feet
<u>Snell Taylor</u> (Name) <u>Belden Miss.</u> (Address)	<u>CLAY + LIMESTONE</u>	<u>0</u>	<u>13</u>
(2) Location: <u>1/4, SW 1/4, Sec. 9 T9 R5E</u>	<u>BLUE MARL</u>	<u>13</u>	<u>120</u>
_____ miles _____, or <u>Belden</u> , (distance) (direction) (Nearest Town)	<u>WATER SAND WITH</u>	<u>120</u>	<u>210</u>
(3) Topography: <input checked="" type="checkbox"/> (Hilly) _____ (Flat) _____ (Level)	<u>ROCKS MIXED</u>		
(4) Purpose of Well: <u>Domestic</u> (Domestic Irrigation Municipal, Industrial, Other)			

Information upon completion of well:

- (1) Diameter 4 inches.
- (2) Total Depth 210' feet.
- (3) Water level 72.53 feet below top of ground. 2/17/67
- (4) Cased to 14', Size 4"
- (5) Screen: Size _____, Length _____
- (6) Were any formations sealed against pollution?
_____ yes, no.

If YES depth of formation _____
Why _____
Drillers Remarks: _____

WL can be measured
111 ELEV 350



(Use Back Side)

Well No.