

LEE MISSISSIPPI BOARD OF WATER COMMISSIONERS

G 27  
11-65

WATER WELL DRILLERS LOG

Date: November, 19 65, Driller: Johnny Webb County Lee  
Leam (Name)

	Description & Color of Materials Sand, Clay, Red Clay, Shell, etc.	Thick- ness Feet	Depth Feet
(1) Owner of Land: <u>Lynn Gibson</u> (Name)	<u>Clay to 15'</u>		
<u>Balden Mississippi</u> (Address)	<u>Blue mud 15' to 180'</u>		
(2) Location: <u>1/4, SW 1/4, Sec. 8 T. 9 R. 5, S E</u>	<u>water sand 180 - 210'</u>		
<u>2</u> miles <u>West</u> , of <u>Balden</u> , (distance) (direction) (Nearest Town)			
(3) Topography: <u>X</u> (Hilly) (Flat) (Level)			
(4) Purpose of Well: <u>Domestic</u> (Domestic Irrigation Municipal, Industrial, Other)			

Information upon completion of well:


- (1) Diameter 4 inches.
- (2) Total Depth 290 feet.
- (3) Water Level 115 feet below top of ground.
- (4) Cased to 21', Size 4"
- (5) Screen: Size \_\_\_\_\_, Length \_\_\_\_\_
- (6) Were any formations sealed against pollution?  
\_\_\_\_\_ yes, \_\_\_\_\_ no.

If YES depth of formation \_\_\_\_\_

Why \_\_\_\_\_

Drillers Remarks: \_\_\_\_\_

1162 ELEV 380

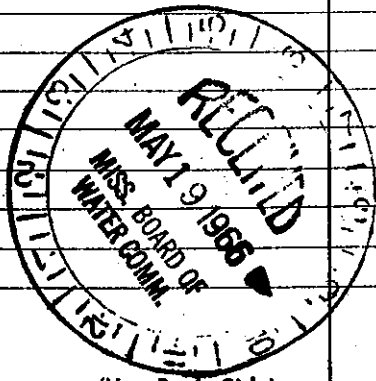

(Use Back Side)

Well No.

Mail this copy to Board of Water Commissioners 429 Miss. St. Jackson. Miss.