

Lee
G 29

8-67 MISSISSIPPI BOARD OF WATER COMMISSIONERS

CODED

WATER WELL DRILLERS LOG

Date: 8-28, 1967, Driller: Herndon-Homan Well & Supply, Inc.
(When well drilled) P. O. Box 42 County Lee
SHANNON, MISSISSIPPI 38600 (Where well is located)

(1) Owner of Land:	Description & Color of Materials	Thick-ness Feet	Depth Feet
<u>C. S. Poole Contractor</u> (Name)	<u>surface clay</u>	<u>0-20</u>	
<u>Tupelo, Miss.</u> (Address)	<u>blue clay</u>	<u>20-400</u>	
(2) Location: <u>NW 1/4, SE 1/4, Sec. 28 T. 15 N. R. 5 E.</u>	<u>sand</u>	<u>480-600</u>	
<u>1/2 miles W</u> , of <u>Tupelo</u> (distance) (direction) (Nearest Town)	<u>bottom</u>	<u>600</u>	
(3) Topography: <u>FLAT</u> (Hilly) (Flat) (Level)			
(4) Purpose of Well: <u>Home</u> (Domestic Irrigation Municipal, Industrial, Other)			

Information upon completion of well:

(1) Diameter 5 inches.

(2) Total Depth 600 feet.

(3) Water Level 125 feet below top of ground.

(4) Cased to 301', Size 5"
294', Size 2"

(5) Screen: Size 2", Length 20'

(6) Were any formations sealed against pollution?
✓ yes, _____ no.

If YES depth of formation 20


Why surface & sand

Drillers Remarks: _____

Yield in gpm: 15

Size pump: 1 1/2 HP SD

Type power: Electric

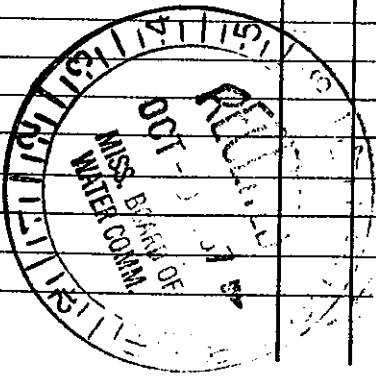

Mail this copy to Board of Water Commissioners 429 Miss. St. Jackson, Miss.