

Lee

MISSISSIPPI BOARD OF WATER COMMISSIONERS

G 30

4-67

CODED

WATER WELL DRILLERS LOG

J. W. Webb

Date: 4-10, 1967, Driller: O.C. Webb, JR County Lee

(Name)

(1) Owner of Land:	Description & Color of Materials Sand, Clay, Red Clay, Shell, etc.	Thick- ness Feet	Depth Feet
O.C. Webb, Jr. (Name) Balden, Miss. (Address)	Red Clay	0	15
(2) Location: NW 1/4, SE 1/4, Sec. 15 T. 95 SE R. 1	Blue Rock	15	100
2 miles W of Tupelo (distance) (direction) (Nearest Town)	Grey Sand	100	170
(3) Topography: Hilly (Hilly) (Flat) (Level)	Blue Rock	170	180
(4) Purpose of Well: DOMESTIC (Domestic Irrigation Municipal, Industrial, Other)			


Information upon completion of well:

- (1) Diameter 5 inches.
- (2) Total Depth 180 feet.
- (3) Water Level 70 feet below top of ground.
- (4) Cased to 21', Size 5"
- (5) Screen: Size None, Length _____
- (6) Were any formations sealed against pollution?
 yes, no.

If YES depth of formation _____

Why _____

Drillers Remarks: _____

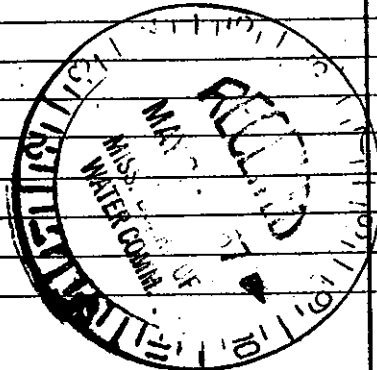

(Use Back Side)

Well No.