

LEE

MISSISSIPPI BOARD OF WATER COMMISSIONERS

G 31

CODED

8-21-62


WATER WELL DRILLERS LOG

Date: Aug 21, 1962, Driller: Otis Webb, Jr., County Lee

	Description & Color of Materials Sand, Clay, Red Clay, Shell, etc.	Thick- ness Feet	Depth Feet
(1) Owner of Land: DAVID THOMPSON (Name) TUPELO RT #1 (Address)	<del>CLAY</del> CLAY	0	25
(2) Location: 1/4, SW 1/4, Sec. 2 T. 9 R. 5 E. 3 miles NW, of TUPELO (distance) (direction) (Nearest Town)	BLUE MARL SAND ROCK SAND	25 55 82 87	55 83 87 190
(3) Topography: <input checked="" type="checkbox"/> (Hilly) <input type="checkbox"/> (Flat) <input type="checkbox"/> (Level)	BLUE MARL ROCK	190	380
(4) Purpose of Well: DOMESTIC (Domestic Irrigation Municipal, Industrial, Other)	WATER SAND	382	510
Information upon completion of well:			
(1) Diameter 4" inches.			
(2) Total Depth 510 feet.			
(3) Water level _____ feet below top of ground.			
(4) Cased to 196', Size 4"			
(5) Screen: Size _____, Length _____			
(6) Were any formations sealed against pollution? _____ yes, <input checked="" type="checkbox"/> no.			
If YES depth of formation _____			
Why _____			
Drillers Remarks: ROCK AT 82' extremely HARD.			
110			

CODED

510  
382  
128

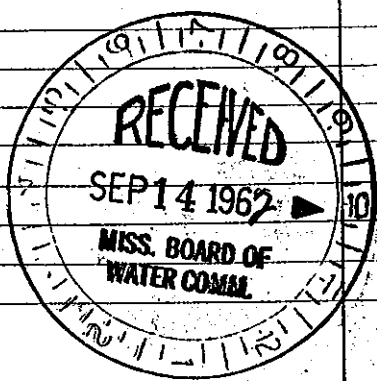

(Use Back Side)

Well No.

Mail this copy to Board of Water Commissioners 429 Miss. St. Jackson, Miss