

LEE  
G 37  
2-68

MISSISSIPPI BOARD OF WATER COMMISSIONERS


CODED

WATER WELL DRILLERS LOG

Date: 2-15, 1968, Driller: O. C. Webb Jr County LL  
(Name)

(1) Owner of Land: <u>Alva Coupland</u> (Name)	Description & Color of Materials Sand, Clay, Red Clay, Shell, etc.	Thick- ness Feet	Depth Feet
<u>Birmingham Ala</u> (Address)	<u>soil</u>	<u>0</u>	<u>14</u>
(2) Location: <u>1/4, 1/4, Sec. 16 T9S R5E</u>	<u>Blue Rock</u>	<u>14</u>	<u>75</u>
<u>1</u> miles <u>East</u> , of <u>Belden</u> (distance) (direction) (Nearest Town)	<u>Water Rock</u>	<u>8"</u>	<u>76</u>
(3) Topography: <input checked="" type="checkbox"/> (Hilly) <input type="checkbox"/> (Flat) <input type="checkbox"/> (Level)	<u>water sand capped</u>	<u>76</u>	<u>185</u>
(4) Purpose of Well: <input checked="" type="checkbox"/> (Domestic Irrigation) <input type="checkbox"/> (Municipal, Industrial, Other)			
Information upon completion of well:			
(1) Diameter <u>5</u> inches.			
(2) Total Depth <u>185</u> feet.			
(3) Water Level <u>40</u> feet below top of ground.			
(4) Cased to <u>2 1/4"</u> , Size <u>5"</u>			
(5) Screen: Size <u>0</u> , Length <u>0</u>			
(6) Were any formations sealed against pollution?			
<u>no</u>			
If YES depth of formation _____			
Why _____			
Drillers Remarks: _____			
_____			
_____			
_____			
_____			

CODED

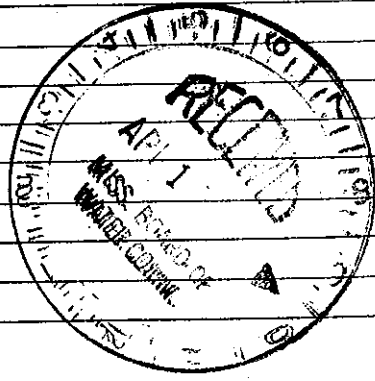

(Use Back Side)

Well No.

Mail this copy to Board of Water Commissioners 429 Miss. St. Jackson. Miss.