

MISSISSIPPI BOARD OF WATER COMMISSIONERS

WATER WELL DRILLERS LOG

OK'd 8/2/69
CODED

LEE
G-55
10-5-62
Date: 10-5, 1962

Driller: Johnny Webb County: Lee
(Name)

(1) Owner of Land: Cecil Pannell
(Name)
Supelo
(Address)

(2) Location: 1/4, 5-95 SE 1/4, Sec. T R,
(distance) (direction) (Nearest Town)
2 miles East of Sherman
(distance) (direction) (Nearest Town)

(3) Topography: (Hilly) (Flat) (Level)

(4) Purpose of Well: (Domestic Irrigation)
 (Municipal, Industrial, Other)

Description & Color of Materials Sand, Clay, Red Clay, Shell, etc.	Thick- ness Feet	Depth Feet
Sand to 12 ft		
white 2 ft Blue		
Marl to 210 ft		
Water Rock 8"		
Water sand		
to 310 ft		
Coffee sand		

CODED

Information upon completion of well:

(1) Diameter 4 inches.

(2) Total Depth 310 feet.

(3) Water Level 95 feet below top of ground.

(4) Cased to 21, Size 4'


(5) Screen: Size _____, Length _____.

(6) Were any formations sealed against pollution?
_____ yes, _____ no.

If YES depth of formation _____

Why _____

Drillers Remarks: _____

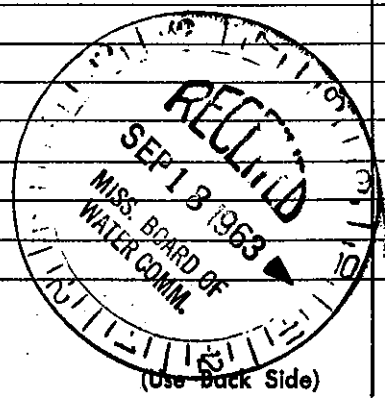

Well No. _____

Mail this copy to Board of Water Commissioners 429 Miss. St. Jackson, Miss.