

Lee  
G  
8-69 2000

MISSISSIPPI BOARD OF WATER COMMISSIONERS

WATER WELL DRILLERS LOG

Date: 8/19, 1966, Driller: Ewing Lee County Lee  
(Name)

(1) Owner of Land:	Description & Color of Materials Sand, Clay, Red Clay, Shell, etc.	Thick- ness Feet	Depth Feet
<u>Billy Wiggins</u> (Name) <u>Saltillo R.T. 1</u> (Address)	<u>hard clay</u>	<u>0</u>	<u>30</u>
(2) Location: <u>1/4</u> , <u>1/4</u> , Sec. <u>15 T9 R5E</u>	<u>blue</u>	<u>50</u>	<u>120</u>
<u>3</u> miles <u>NW</u> , of <u>Jasper</u> (distance) (direction) (Nearest Town)	<u>sand</u>	<u>120</u>	<u>180</u>
(3) Topography: <u>Hilly</u> (Hilly) (Flat) (Level)	<u>blue</u>	<u>180</u>	<u>300</u>
(4) Purpose of Well: <u>Domestic</u> (Domestic Irrigation Municipal, Industrial, Other)	<u>sand</u>	<u>300</u>	<u>470</u>


Information upon completion of well:

- (1) Diameter 4 inches.
- (2) Total Depth 474 feet.
- (3) Water Level 70 feet below top of ground.
- (4) Cased to 185 ft, Size 4 in 1.
- (5) Screen: Size \_\_\_\_\_, Length \_\_\_\_\_.
- (6) Were any formations sealed against pollution?  
\_\_\_\_\_ yes, \_\_\_\_\_ no.

If YES depth of formation \_\_\_\_\_

Why \_\_\_\_\_

Drillers Remarks: \_\_\_\_\_

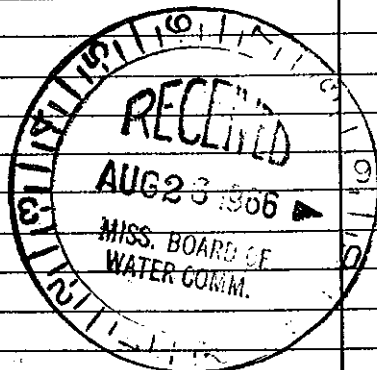

Well No

(Use Back Side)

Mail this copy to Board of Water Commissioners 429 Miss. St. Jackson, Miss