

MISSISSIPPI BOARD OF WATER COMMISSIONERS

LEE insufficient information
 off for further

WATER WELL DRILLERS LOG

10-12-60

Herndon Well & Supply Co.

Date Oct 12, 1960, Driller: SHANNON, MISS. County Lee

(Name)

(1) Owner of Land: Fred Bell
 (Name)
Massville Miss.
 (Address)

(2) Location: SW 1/4 NE 1/4, Sec 25 T. 8 R. 9S 6E
 (distance) (direction) (Nearest Town)

(3) Topography: Hilly
 (Hilly) (Flat) (Level)

(4) Purpose of Well: Home Use
 (Domestic Irrigation
 Municipal, Industrial, Other)

Description & Color of Materials Sand, Clay, Red Clay, Shell, etc.	Thick- ness Feet	Depth Feet
<u>sand & clay</u>		<u>28</u>
<u>blue rock</u>		
<u>sand</u>	<u>190</u>	
<u>Bottom</u>		<u>224</u>

Information upon completion of well:

(1) Diameter 4 inches.

(2) Total Depth 294 feet.

(3) Water Level _____ feet below top of ground.

(4) Cased to 30 ft, Size 4 in.


(5) Screen: Size _____, Length _____.

(6) Were any formations sealed against pollution?
 yes, _____ no.

If YES depth of formation 28 ft

Why Surface & Sand

Drillers Remarks: _____

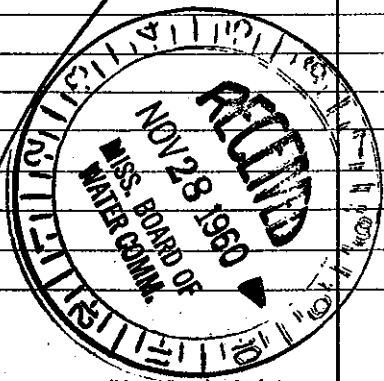

(Use Back Side)

Well No.

156 ?

Retain this copy for your office files.