

MISSISSIPPI BOARD OF WATER COMMISSIONERS

WATER WELL DRILLERS LOG

LEE
0 ft
7-7-60

2

Date: 7-7-60, 1960, Driller: Living Jackson County
(Name)

(1) Owner of Land: L.A. Snuggs
(Name)
Thru
(Address) Et 4 956E
(2) Location: 1/4, 1/4, Sec. 4 T. R
1/2 miles W of East Tupelo
(distance) (direction) (Nearest Town)
(3) Topography: (Hilly) (Flat) (Level)
(4) Purpose of Well: Domestic
(Domestic Irrigation, Municipal, Industrial, Other)

| Description & Color of Materials Sand, Clay, Red Clay, Shell, etc. | Thick- ness Feet | Depth Feet |
|---|------------------------|---------------|
| <u>Joint Clay</u> | | |
| <u>Blue "</u> | <u>0</u> | <u>50</u> |
| <u>Sand</u> | <u>50</u> | <u>250</u> |
| | <u>250</u> | <u>329</u> |


Information upon completion of well:

(1) Diameter 4 inches.
(2) Total Depth 329 feet.
(3) Water Level 70 feet below top of ground.
(4) Cased to 57', Size 4"
(5) Screen: Size 7/8" Length _____
(6) Were any formations sealed against pollution?
 yes, no.

If YES depth of formation 70'

Why _____

Drillers Remarks: _____

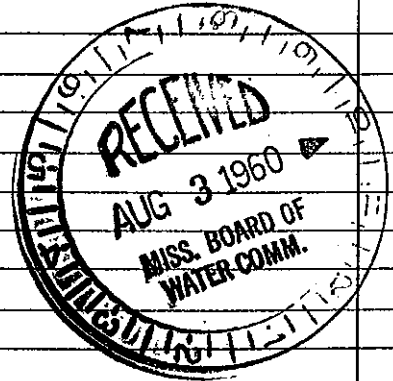

59

Well No.

(Use Back Side)

Mail this copy to Board of Water Commissioners 429 Miss. St. Jackson, Miss.