


Lee
H 42
8-66

MISSISSIPPI BOARD OF WATER COMMISSIONERS

WATER WELL DRILLERS LOG

Date: 8-16-, 1966, Driller: Layne-Central Co. County Lee
(Name)

(1) Owner of Land: <u>City of Tupelo</u> (Name)	Description & Color of Materials Sand, Clay, Red Clay, Shell, etc.	Thick- ness Feet	Depth Feet
<u>Tupelo, Mississippi</u> (Address)	Clay	0	12
(2) Location: <u>1/4</u> , <u>1/4</u> , Sec. <u>1</u> T. <u>1</u> R. <u>1</u>	sand	12	17
<u>1</u> miles <u>1</u> of <u>1</u> (distance) (direction) (Nearest Town)	clay	17	83
(3) Topography: <u>1</u> (Hilly) (Flat) (Level)	rock	83	85
(4) Purpose of Well: <u>Municipal</u> (Domestic Irrigation Municipal, Industrial, Other)	hard blue clay	85	244
Information upon completion of well:	sand clay	244	335
(1) Diameter <u>16</u> inches.	sand-shale st.	335	400
(2) Total Depth <u>562'</u> feet.	shale-sand st.	400	460
(3) Water Level <u>167</u> feet below top of ground.	hard gumbo	460	508
(4) Cased to <u>501'</u> , Size <u>16"</u>	rock	508	510
(5) Screen: Size <u>10"</u> , Length <u>50'</u>	shale-sand st.	510	521
(6) Were any formations sealed against pollution? <u>X</u> yes, <u> </u> no.	chert-shale st.	521	530
If YES depth of formation <u>501'</u>	rock	530	531
Why <u> </u> required	chert	531	558
Drillers Remarks: <u> </u>	rock	558	567
<u>358</u>	soapstone	561	574
	rock	574	576
	soapstone-rock st.	576	603
	rock	603	608

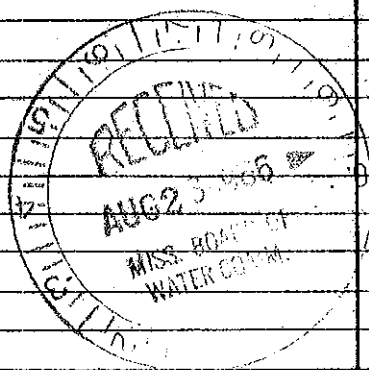

(Use Back Side)

Well No.