

MISSISSIPPI BOARD OF WATER COMMISSIONERS

LEE

H43 WATER WELL DRILLERS LOG

8-60

Date: Aug, 1960, Driller: O.C. Webb County Lee

(Name)

(1) Owner of Land: Cecil Bruff
(Name)

Description & Color of Materials
Sand, Clay, Red Clay, Shell, etc.

Thick-
ness
Feet

Depth
Feet

Hunttown Miss
(Address)

Soil 15 ft
sand to 40 ft
Blue Rock to

(2) Location: NE 1/4, SE 1/4, Sec. 8 T9R6,

6 miles north of Tupelo
(distance) (direction) (Nearest Town)

220 ft water
Rock & water
sand to 320 ft

(3) Topography: (Hilly) (Flat) (Level)

(4) Purpose of Well: (Domestic Irrigation) (Municipal, Industrial, Other)

Information upon completion of well:

(1) Diameter 4 inches.

(2) Total Depth 320 feet.

(3) Water Level 80 feet below top of ground.

(4) Cased to 45 ft, Size 4


(5) Screen: Size 0, Length 0

(6) Were any formations sealed against pollution?
_____ yes, _____ no.

If YES depth of formation _____

Why _____

Drillers Remarks: _____

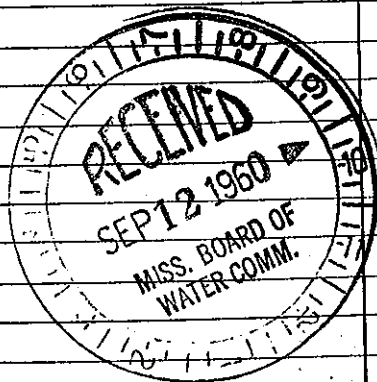

62 ELEV 295

(Use Back Side)

Well No.