

LEE MISSISSIPPI BOARD OF WATER COMMISSIONERS

H 44

WATER WELL DRILLERS LOG

1-20-62

Date: 1-20, 1962, Driller: O. C. Webb County Lee

(Name)

(1) Owner of Land: W. T. W. V. Chambliss

(Name)

Jupelo miss

(Address)

(2) Location: 1/4, 1/4, Sec. 6 T9R6

3 miles North of Jupelo

(distance) (direction) (Nearest Town)

(3) Topography: (Hilly) (Flat) (Level)

(4) Purpose of Well: (Domestic Irrigation) (Municipal, Industrial, Other)

Description & Color of Materials Sand, Clay, Red Clay, Shell, etc.

Thick-ness Feet

Depth Feet

soil to 15 ft
sand to 75 ft
Blue mail to 315 ft
Water Rock
6" water sand to 450 ft

SP COND 275

Information upon completion of well:

- (1) Diameter 4 inches.
(2) Total Depth 450 feet.
(3) Water Level 85 feet below top of ground.
(4) Cased to 80, Size 4"
(5) Screen: Size 0, Length 0
(6) Were any formations sealed against pollution? no.


If YES depth of formation

Why

Drillers Remarks:

WL 110.25 2-13-67

133 ELEV 330

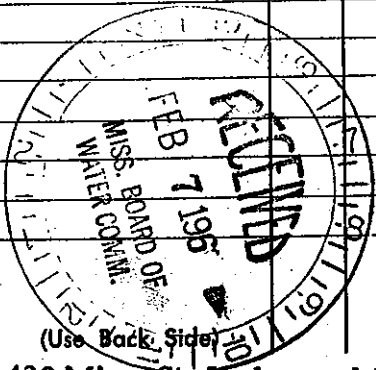

Well No.

Mail this copy to Board of Water Commissioners 429 Miss. St. Jackson, Miss.