

LEE

MISSISSIPPI BOARD OF WATER COMMISSIONERS

H 47

H-305

5-31-60

WATER WELL DRILLERS LOG

#306

HERNDON WELL & SUPPLY CO.

Date May 31, 1960, Driller: P. O. BOX 42 County Lee


SHANNON, MISSISSIPPI

(1) Owner of Land:	Description & Color of Materials Sand, Clay, Red Clay, Shell, etc.	Thick- ness Feet	Depth Feet
<u>Douglas Buchanan</u> (Name)			
<u>Tupelo, Miss.</u> (Address)	<u>Surface sand</u>		<u>0</u>
(2) Location: <u>NE 1/4, NE 1/4, Sec 35 T. 16 R. 6E</u>	<u>+ clay</u>		
_____ miles <u>East</u> of <u>Tupelo</u> (distance) (direction) (Nearest Town)	<u>Blue rock</u>		<u>16</u>
(3) Topography: <u>Flat</u> (Hilly) (Flat) (Level)	<u>sand</u>		<u>140</u>
(4) Purpose of Well: <u>Home use</u> (Domestic Irrigation Municipal, Industrial, Other)	<u>Bottom</u>		<u>260</u>

Information upon completion of well:

see sketch for 143

- (1) Diameter 4 inches.
- (2) Total Depth 260 feet.
- (3) Water Level 90 feet below top of ground.
- (4) Cased to 20' 16", Size 4"
- (5) Screen: Size _____, Length _____.
- (6) Were any formations sealed against pollution?
 yes, _____ no.

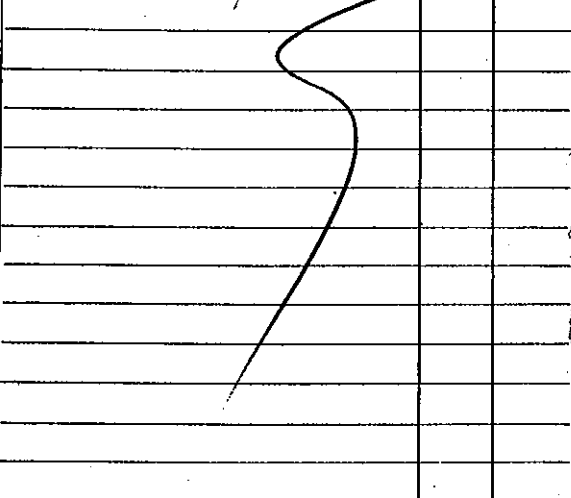

If YES depth of formation 16'


Why Surface + sand

Drillers Remarks: Drick house on

was part house on

jet pump 1/2 H.P.

U-B ELK 300

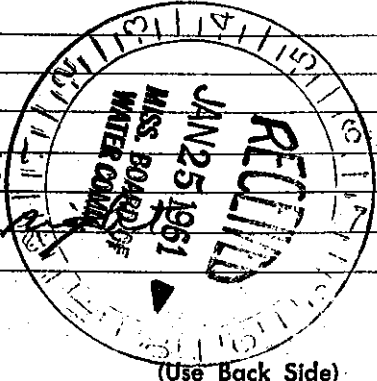

(Use Back Side)

Well No.