


LEE MISSISSIPPI BOARD OF WATER COMMISSIONERS

H 49
9-65

WATER WELL DRILLERS LOG

Date: Sept, 1965, Driller: Johnny Well County Lee
Tackett (Name)

| | Description & Color of Materials Sand, Clay, Red Clay, Shell, etc. | Thick- ness Feet | Depth Feet |
|---|---|------------------------|---------------|
| (1) Owner of Land: <u>Joe Zuckitt</u> (Name) <u>Edge Line, Mississippi</u> (Address) | Clay to 30' | | |
| (2) Location: <u>1/4, 1/4, Sec. 25 T 9 R 6</u> <u>3 miles East</u> of <u>Zupolo, Miss</u> (distance) (direction) (Nearest Town) | Blue Marl 30 to 180' | | |
| (3) Topography: <u>X</u> (Hilly) (Flat) (Level) | Water Sand 180 to 300' | | |
| (4) Purpose of Well: <u>Domestic</u> (Domestic Irrigation Municipal, Industrial, Other) | see sketch for 151 ON 146 | | |
| Information upon completion of well: | | | |
| (1) Diameter <u>4</u> inches. | | | |
| (2) Total Depth <u>300</u> feet. | | | |
| (3) Water Level <u>90'</u> feet below top of ground. | | | |
| (4) Cased to <u>42'</u> , Size <u>4"</u> | | | |
| (5) Screen: Size _____, Length _____ | | | |
| (6) Were any formations sealed against pollution? _____ yes, _____ no. | | | |
| If YES depth of formation _____ | | | |
| Why _____ | | | |
| Drillers Remarks: <u>Shall have new</u> | | | |
| 151 ELEV 340 | | | |

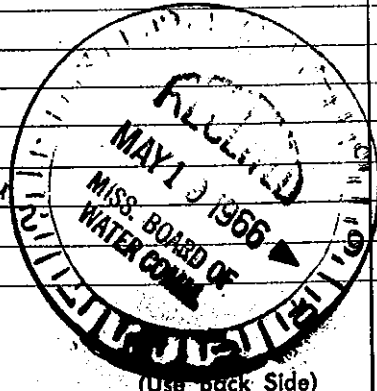

Well No.

Mail this copy to Board of Water Commissioners 429 Miss. St. Jackson. Miss.