


LEE WA
 H 31
 8-18-60
 Date: Aug 18, 1960 Driller: LANNON, MISS. Supply Co. #300
 County Lee

	Description & Color of Materials Sand, Clay, Red Clay, Shell, etc.	Thick- ness Feet	Depth Feet
(1) Owner of Land: <u>John C. Robbins</u> (Name) <u>Tupelo, Miss</u> (Address)	<u>Sand & clay</u>		<u>21</u>
(2) Location: $\frac{1}{4}$, $\frac{1}{4}$, Sec. <u>24 T. 9 R. 6</u>	<u>Blue loam</u>		<u>21</u>
<u>3</u> miles <u>NE</u> of <u>Tupelo</u> (distance) (direction) (Nearest Town)	<u>Sand & Bottom</u>		<u>168</u>
(3) Topography: <u>Hilly</u> (Hilly) (Flat) (Level)			<u>273</u>
(4) Purpose of Well: <u>Home Use</u> Domestic Irrigation Municipal, Industrial, Other			

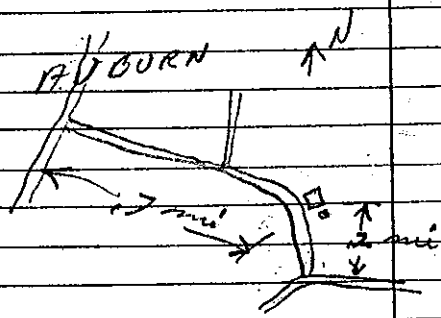

Information upon completion of well:

- (1) Diameter 4 inches.
- (2) Total Depth 273 feet.
- (3) Water Level 25 feet below top of ground.
- (4) Cased to 21 ft Size 4"
- (5) Screen: Size —, Length —
- (6) Were any formations sealed against pollution?
 yes, no.
- If YES depth of formation 20
- Why Surface & Sand
- Drillers Remarks: Get pump 1/2 hp
can't measure W.L.



121 GLEN 310
 Retain this copy for your office files.

(Use Back Side)

Well No.
H 300