


H52
7-1-63

WATER WELL DRILLERS LOG

Date: 7/1, 1963, Driller: HERNDON WELL & SUPPLY Co. County Lee
P.O. BOX 42
SHANNON, MISSISSIPPI

| (1) Owner of Land: | Description & Color of Materials Sand, Clay, Red Clay, Shell, etc. | Thick- ness Feet | Depth Feet |
|--|---|------------------------|---------------|
| Bill Watts (Name) Tupelo, Miss. (Address) | surface sand | 0 | 0 |
| (2) Location: 1/4, 1/4, Sec 27 T. R. 6 1 miles NE of Tupelo. (distance) (direction) (Nearest Town) | clay shale | 150 | 150 |
| (3) Topography: Hilly (Hilly) (Flat) (Level) | sand | 190 | 190 |
| (4) Purpose of Well: Domestic (Domestic Irrigation Municipal, Industrial, Other) | shale | 240 | 240 |
| Information upon completion of well: | | | |
| (1) Diameter 4 inches. | sand | 320 | 320 |
| (2) Total Depth 460 feet. | sand | 320 | 320 |
| (3) Water Level 180 feet below top of ground. | Bottom | 460 | 460 |
| (4) Cased to 253' Size 4" | See 122 sketch | | |
| (5) Screen: Size _____, Length _____ | | | |
| (6) Were any formations sealed against pollution? <input checked="" type="checkbox"/> yes, <input type="checkbox"/> no. | | | |
| If YES depth of formation 275' | | | |
| Why surface sand | | | |
| Drillers Remarks: near major in rocks sub | | | |
| 145 ELEV 415 | | | |

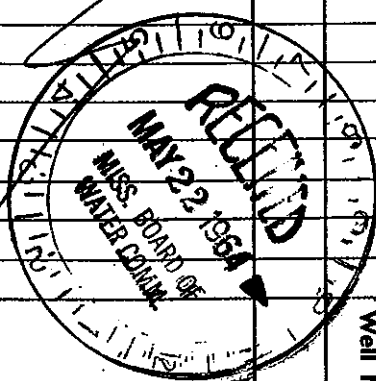

Well No.

(Use Back Side)