

LEE

MISSISSIPPI BOARD OF WATER COMMISSIONERS

H53

WATER WELL DRILLERS LOG

10-19-65

Herndon-Homan Well & Supply, Inc.

Date: Apr. 19, 1963, Driller:

P. O. Box 42 County See

SHANNON MISSISSIPPI 38868

(1) Owner of Land: Walter Duvard
(Name)

At Tupelo, Miss.
(Address)

(2) Location: NE 1/4, NW 1/4, Sec 24 T9R6E
4 miles NE, of Tupelo
(distance) (direction) (Nearest Town)

(3) Topography: flat
(Hilly) (Flat) (Level)

(4) Purpose of Well: Domestic
(Domestic Irrigation
Municipal, Industrial, Other)

Description & Color of Materials Sand, Clay, Red Clay, Shell, etc.	Thick- ness Feet	Depth Feet
<u>surface sand & clay</u>	<u>0 - 10</u>	
<u>blue clay and sand</u>	<u>10 - 40</u>	
<u>blue clay</u>	<u>40 - 280</u>	
<u>sand</u>	<u>280 - 300</u>	
<u>Bottom</u>	<u>300</u>	

Information upon completion of well:

(1) Diameter 4 inches.


(2) Total Depth 300 feet.

(3) Water Level 90 feet below top of ground.

(4) Cased to 42', Size 4"

(5) Screen: Size —, Length —


(6) Were any formations sealed against pollution?
 yes, no.

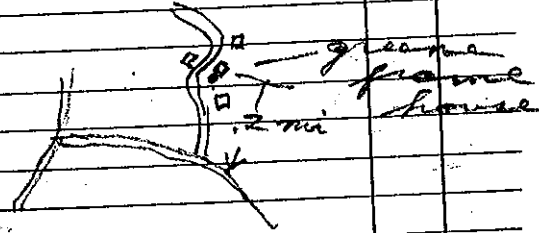

If YES depth of formation 40'

Why surface & sand

Drillers Remarks:

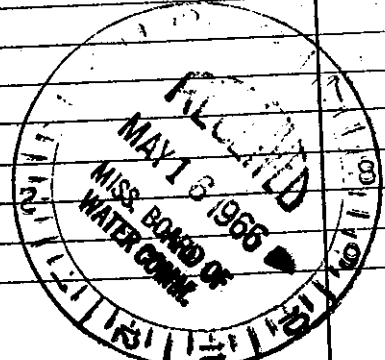

152 ELEV 350

Well No.

(Use Back Side)

Mail this copy to Board of Water Commissioners 429 Miss. St. Jackson, Miss.