

LEE MISSISSIPPI BOARD OF WATER COMMISSIONERS

H 54
5-19-61

WATER WELL DRILLERS LOG
HERNDON WELL & SUPPLY CO. #305
A-306

Date: May 19, 1961, Driller: SHANNON, MISSISSIPPI County Lee
P. O. BOX 42
(Name)

(1) Owner of Land: <u>J.A. Wyllie</u> (Name)	Description & Color of Materials Sand, Clay, Red Clay, Shell, etc.	Thick- ness Feet	Depth Feet
<u>RT 2 Tupelo, Miss</u> (Address)	<u>Surface sand</u>		<u>0</u>
(2) Location: <u>NW 1/4, NE 1/4, Sec. 22, T. 23 N., R. 6 E.</u> (distance) (direction) (Nearest Town)	<u>clay</u> <u>to</u> <u>blue sand</u>		<u>135</u>
(3) Topography: <u>Hilly</u> (Hilly) (Flat) (Level)	<u>sand</u>		<u>260</u>
(4) Purpose of Well: <u>Home use</u> (Domestic Irrigation Municipal, Industrial, Other)	<u>to</u> <u>Bottom</u>		<u>380'</u>



Information upon completion of well:

- (1) Diameter 4 inches.
- (2) Total Depth 380 feet.
- (3) Water Level _____ feet below top of ground.
- (4) Cased to 143'5", Size 4"
- (5) Screen: Size _____, Length _____
- (6) Were any formations sealed against pollution?
 yes, _____ no.

If YES depth of formation 135'

Why Surface & sand

Drillers Remarks: _____

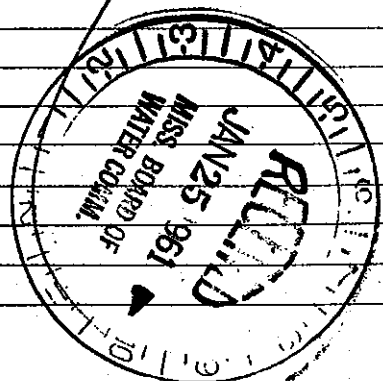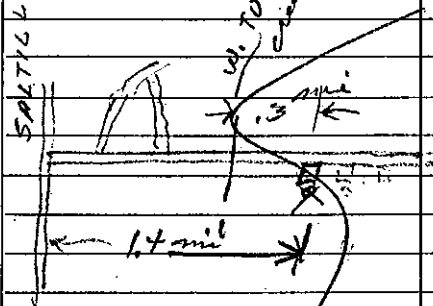

(Use Back Side)

Well No.

127 ELEV 380