

LEE MISSISSIPPI BOARD OF WATER COMMISSIONERS

H 55

7-19-65

WATER WELL DRILLERS LOG

Date: July 19, 1965, Driller: Herndon-Homan Well & Supply, Inc.  
P. O. Box 42 County Lee  
SHANNON, MISSISSIPPI 38868.

(1) Owner of Land: Charles Maxwell  
 (Name)  
Box 4 Tupelo, Miss.  
 (Address)  
 (2) Location: 1/4, NE 1/4, Sec 25 T. 16 S. R. 6 E.  
4 miles E of Tupelo  
 (distance) (direction) (Nearest Town)  
 (3) Topography: Hilly  
 (Hilly) (Flat) (Level)  
 (4) Purpose of Well: Domestic  
 (Domestic Irrigation, Municipal, Industrial, Other)

Description & Color of Materials Sand, Clay, Red Clay, Shell, etc.	Thick- ness Feet	Depth Feet
<u>surface sand &amp; clay</u>	<u>0</u>	<u>35</u>
<u>Blue clay</u>	<u>35-180</u>	
<u>Sand</u>	<u>180-300</u>	
<u>Bottom</u>	<u>300'</u>	


  

Information upon completion of well:

(1) Diameter 4 inches.  
 (2) Total Depth 300 feet.  
103.0, 2/23/65  
 (3) Water Level 120 feet below top of ground.  
 (4) Cased to 36' 3", Size 4"  
 (5) Screen: Size \_\_\_\_\_, Length \_\_\_\_\_  
 (6) Were any formations sealed against pollution?  
 \_\_\_\_\_ yes, \_\_\_\_\_ no.

If YES depth of formation \_\_\_\_\_  
 Why \_\_\_\_\_  
 Drillers Remarks: See

150 ELEV 330

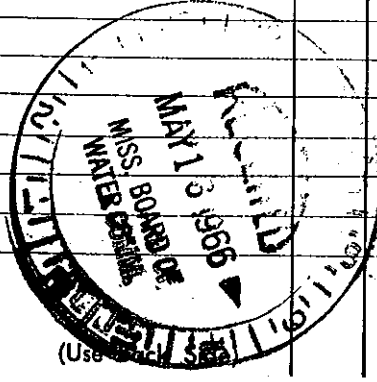

Well No.